

**DESIGN DATA**

CODE OF CONSTRUCTION		ASME SEC. VIII DIV.1, 2007 Edn. TEMA CLASS-R 9th EDITION, 2007		SHELL		CHANNEL	
DESIGN PRESSURE (SEE NOTE-32)		UNIT		PWHT		YES	
DESIGN TEMPERATURE		SHELLSIDE TUBE SIDE		RADIOGRAPHY		100%	
HYDROTEST PRESSURE (SEE NOTE-33)		Kg/Cm <sup>2</sup> / 102.6 / F/10830C		JOINT EFFICIENCY		1.0	
DIFFERENTIAL DESIGN PRESSURE FOR TUBES/TS.		KPa		INSPECTION BY		A/EIL	
MIN. HYDRO TEST TEMPERATURE		°C		POSITION		HORIZONTAL	
OPERATING PRESSURE		Kg/Cm <sup>2</sup> / 87.7		DUTY		MM Kcal/hr	
OPERATING TEMPERATURE (IN / OUT)		°C		EARTHQUAKE SPECIFICATION		EL 370-6879-9-2584-0146.	
INSIDE DIAMETER		mm		WIND LOAD		IS 875	
No. OF PASSES		Nos.		ADDITIONAL LOADING AS PER UG-22		NOZZLE LOADS	
FLUID CIRCULATED		REACTOR FEED		CODE STAMPING REQUIRED		YES 'U'	
INSULATION		mm		TOLERANCE		TEMA CLASS R & EIL STD. 7-15-0019 REV.1	
CORRN. ALLOWANCE		mm		MECHANICAL DATA OF EXCHANGER			
MAWP FULLY CORRODED (AT DESIGN TEMP.)		10062 kPag AT 173 °C SHELL SIDE		EFFECTIVE SURFACE AREA		m <sup>2</sup> 582	
MAWP FULLY CORRODED (AT AMBIENT TEMP.)		8375 kPag AT 224 °C TUBE SIDE		TOTAL WEIGHT (EMPTY)		Kg. 62159	
MAWP UNCORRODED (AT DESIGN TEMP.)		10062 kPag AT 173 °C SHELL SIDE		TUBE BUNDLE WEIGHT		Kg. 19000	
MAWP UNCORRODED (AT AMBIENT TEMP.)		8375 kPag AT 224 °C TUBE SIDE		HYDRO TEST WEIGHT		Kg. 76543	
MDMT		15 °C AT 10062 kPag SHELL SIDE		OPERATING WEIGHT		Kg. 70750	
		15 °C AT 8375 kPag TUBE SIDE		BUNDLE PULLING LOAD		Kg. 38000	

\* AS PER GENERAL NOTE-35

T2B	CHANNEL OUTLET	400	80	21.44	600#	WN	RF
T1B	CHANNEL INLET	400	80	21.44	600#	WN	RF
S2B	SHELL OUTLET	350	FORG.	23.80 (19.05) / Δ	900#	WN	RTJ
S1B	SHELL INLET	350	FORG.	23.80 (19.05) / Δ	900#	WN	RTJ
NOZZ. No.	SERVICE	SIZE DN	SCH	THK	CLASS	TYPE	REMARK
					ASME B16.5 2003	FLANGES	

**NOZZLE SCHEDULE**

**TUBE SIDE ADDITIONAL CONDITIONS :-** Δ

DEPRESSURIZATION PRESSURE	73.0 Kg/cm <sup>2</sup> g
DEPRESSURIZATION TEMPERATURE	299 °C

**HEAT TREATMENT PROCEDURE :-** Δ

ITEM DESCRIPTION	HEATING METHOD	TYPE OF HEAT TREATMENT	LOADING TEMP. (°C)	RATE OF HEATING (°C/HOUR)	SOAKING TEMP. (°C)	SOAKING TIME	RATE OF COOLING (°C/HOUR)	UNLOADING TEMP. (°C)
MAIN SHELL ASSEMBLY	IN CLOSED FURNACE	SR	300	80	620-640	150 Minutes	80	300
CHANNEL BARREL ASSEMBLY	IN CLOSED FURNACE	SR	300	55	620-640	160 Minutes	55	300
INTERNAL CYLINDER ASSEMBLY	IN CLOSED FURNACE	SR	300	100	620-640	150 Minutes	100	300
MAIN SHELL TO BARREL JOINT	BY HEAT RESISTANCE COIL	SR	300	75	620-640	150 Minutes	75	300
TUBE TO TUBESHEET JOINT	ELECTRICAL RESISTANCE	SR	300	100	620-640	60 Minutes	100	300
'U' TUBE AFTER FORMING 'U' BEND-300mm FROM TL (RT TO RW)	IN CLOSED FURNACE	SR	300	150	620-640	30 Minutes	150	300

3	07.01.2010	AS BUILT DIMENSIONS ARE SHOWN IN BKT (-) AS MARKED Δ AND OTHER CHANGES AS MARKED Δ THUS.	PRASHANT	VED	GDP
2A	23.02.2009	DRAWING IS REVISED AS PER EIL COMMENTS AS MKD. Δ THUS.	BSB	VDP	GDP
2	08.01.2009	DRAWING IS REVISED AS PER EIL COMMENTS AS MKD. Δ THUS.	BSB	VDP	GDP
1	08.09.2008	DRAWING IS REVISED AS PER EIL COMMENTS AS MKD. Δ THUS.	BSB	VDP	GDP
0	15.04.2008	SUBMITTAL FOR APPROVAL	BSB	VDP	GDP
REV.	DATE	DESCRIPTION	DRWN	CHKD	APPD

PROJECT NAME : **DHDT, EURO-IV**

ENGINEERING & MANUFACTURER: **TEMA INDIA LTD.**

CONSULTANT: **ENGINEERS INDIA LIMITED**

CLIENT: **CPCL REFINERY III** 256

TITLE: **FIRST REACTOR FEED / EFFLUENT EXCHANGER** W.O. No. 07-386

EQPT. NO. 211-E-1F

JOB NO. EIL 6879 P.O.No. 6879/60/10/1008/018 DT. 27/02/2008

SCALE NTS DWG. No. SDB/E/071204 PR.No. 6879-211-EE-PR-602/0018 Rev.0 DT. 03/04/2008

SHT. NO. 1 of 18 Rev. 3

**AS BUILT**

**ENGINEERS INDIA LTD.**

**SUBRESH KUMAR**

**INSPECTION**

**EIL 132**

*Reviewed*

*15/01/2010*

*AS*



**GENERAL NOTES :-**

- 1] ALL DIMENSIONS ARE IN mm UNLESS OTHERWISE SPECIFIED.
- 2] ALL BOLT HOLES SHALL STRADDLE THE PRINCIPAL CENTRE LINE.
- 3] ALL SHARP CORNERS SHALL BE ROUNDED OFF TO MINIMUM RADIUS.
- 4] IF BACK CHIPPING IS NOT POSSIBLE THEN ROOT RUN SHALL BE DONE BY TIG. ALL ACCESSIBLE WELDS TO BE BACK CHIPPED & WELDED FROM OTHER SIDE.
- 5] STANDOUTS FOR NOZZLES WELDED ON SHELL & CHANNEL SHALL BE MEASURED FROM THE CENTRE LINE OF THE EXCHANGER.
- 6] ALL INTERNAL WELDS IN THE SHELL SHALL BE GROUND FLUSH IN ORDER TO INSERT AND REMOVE TUBE BUNDLE. ALSO ALL INTERNAL WELDS SHALL BE GROUND FLUSH TO THE EXTENT OF FACILITATING DRAINING OF COMPLETE EQUIPMENT. ALL OTHER WELD MAY BE LEFT IN THE DESCALED CONDITION ONLY.
- 7] ALL WELDS SHALL BE D.P. CHECKED OR MAGNETIC PARTICLE (MT) TESTED AFTER BACK CHIPPING.
- 8] ALL FORGINGS SHALL BE ULTRASONICALLY EXAMINED AS PER ASME Sec. II, SA-388. ACCEPTANCE STANDARD SHALL BE IN ACCORDANCE WITH PARA 3.3.4 OF ASME Sec. VIII Div. 2 CODE. SCANNING SHALL BE 100%.
- 9] ALL FORGINGS SHALL BE IN NORMALISED AND TEMPERED CONDITION.
- 10] INSIDE EDGES OF TUBE HOLES IN TUBESHEET SHALL BE FREE OF BURRS TO PREVENT CUTTING OF THE TUBES.
- 11] ALL FABRICATION, INSPECTION & TESTING REQUIREMENT SHALL BE AS PER PR & APPROVED QAP. PROJECT SPECIFICATION & ASME. CODE
- 12] SUPPORT PLATE & BAFFLE PLATE DISTANCES ARE GIVEN FROM CENTER TO CENTER'S BUILT
- 13] HEMI SPHERICAL HEAD SHALL BE IN SINGLE PIECE CONSTRUCTION  
HEMISPHERICAL HEADS SHALL BE SUBJECTED TO DYE PENETRANT TEST (BOTH INSIDE & OUTSIDE) AFTER HEAT TREATMENT.
- 14] APPROVAL ON WPS AND PQR SHALL BE OBTAINED PRIOR TO FABRICATION.
- 15] ALL GASKET SHALL BE MADE IN SINGLE PIECE CONSTRUCTION.  $\Delta$
- 16] ALL SPIRAL WOUND GASKET FOR SHELL SIDE SHALL BE 6.35 MM THK AISI 321 WITH GRAFOIL FILLER AND 4.5 THK AISI 321 OUTER RING.
- 17] 'T' DENOTES MATCH MARK FOR ASSEMBLY AND SHALL BE PUNCHED ON ALL MATING PARTS. *Reviewed*
- 18] ALL MATERIALS SHALL BE SUPPLIED WITH MILL TEST CERTIFICATE DULY CERTIFIED BY TPI. *Reviewed*
- 19] REFER PARA 2.1.2 OF 6-15-0001 REV.3. *Reviewed*
- 20] DELETED.  $\Delta$
- 21] THE HEAT EXCHANGER SHALL BE PROVIDED WITH PRESSURE GAUGE TO MONITOR N<sup>2</sup> PRESSURE (0.25 Kg/cm<sup>2</sup>) AND 1/2" NON RETURN VALVE AS PER 6-15-0001 REV.3. PARA 9.1.
- 22] EQPT. SHALL BE DRIED & THOROUGHLY CLEANED BOTH INSIDE AND OUTSIDE AND ALL WATER, DIRT, SAND, WELD METAL, SPATTER, WELD ELECTRODES, STUB & FOREIGN MATERIALS SHALL BE REMOVED.
- 23] FOR CONSTRUCTIONAL DETAILS AND NOMENCLATURES REFER EIL STANDARDS.  
EIL PR NO. 6879-211-EE-MR-6020 REV.B EIL THERMAL DATASHEET 6879-211-05-45-DS-001 REV.2.  
GENERAL SPEC. 6-15-0001 REV.3, 6-15-0003 REV.2, 6-15-0006 REV.3,  
6-15-0021 REV.3, 6-15-91 REV.1, 6-12-0018 REV.2, 6-81-0001 REV.0 & 6-81-009 REV.1  
7-15-0001 REV.2, 7-15-0002 REV.2, 7-15-0005 REV.2, 7-15-0007 TO 0009 REV-2,  
7-15-0016 REV.2, 7-15-0017 REV.2, 7-15-0018 REV.2, 7-15-0019 REV.2, 7-76-0101 REV.3.
- 24] ALL OF THE REMOVABLE PARTS SHALL BE STAMPED WITH THE ITEM NUMBER.
- 25] a) PAINTING (SHOP PRIMER) OF EXCHANGERS SHALL BE AS FOLLOWS. :-  
THE EXTERNAL SURFACE SHALL BE PREPARED FOR PAINTING BY BLAST CLEANING TO NEAR WHITE FINISH AS PER SSPC-SP-10 [SA 2 1/2 SWEDISH STANDARD (SIS-05-5900)]. SHOP PRIMER SHALL BE ORGANIC ZINC SILICATE COATING 65-75 MICRONS DFT.  
c) GASKET CONTACT SURFACES SHALL BE PROTECTED WITH RUST PREVENTIVE COMPOUND.

- 25] SPARE PARTS :- MANDATORY SPARES  
STUD BOLTS/NUTS :- (ONE SET OF EACH SIZE OF NOZZLE WITH BLIND FLG.)  
GASKET :- 400% (EACH NOZZLE WITH BLIND FLG. & GIRTH JOINTS)  
GASKET RETAINER :- 100% (DIAPHRAGMS)  
PUSH RODS :- 100%  
SPARE PARTS :- COMMISSIONING SPARES  
GASKET :- 200% (EACH NOZZLE WITH BLIND FLG. & GIRTH JOINTS)

**26] CORROSION ALLOWANCE**

SHELL, SHELL COVER	6mm
CHANNEL	6mm
TUBE SHEET	12mm

- 27] ANCHOR BOLT MATERIAL HAVE BEEN DESIGNED CONSIDERING A SHEAR STRESS OF 865 kgf/cm<sup>2</sup> (SCOPE OF SUPPLY BY OTHERS)
- 28] ALL BOLTING AND THREADS ON THE BARREL SHALL BE LUBRICATED WITH HIGH TEMPERATURE THREAD LUBRICANT VIZ. NI-GRAPHITE COMPOUND TO PREVENT SEIZURE.
- 29] REQUIREMENTS OF ALL PR SPECIFICATION DOCUMENTS SHALL BE COMPLIED WITH UNLESS OTHERWISE AGREED BETWEEN EIL & TEMA.
- 30] CHANNEL BARREL THREADS AND LOCK RING THREADS SHALL BE 100% DP EXAMINED.
- 31] THE MINIMUM TUBE WALL THICKNESS AT THE BEND PORTION AS PER TEMA CLAUSE RC8-2.31.
- 32] THE DIFFERENTIAL DESIGN PRESSURE FOR EXCHANGER = 27.5 Kg/cm<sup>2</sup>g.  
PERMITTED EXTERNAL HYDROTEST PRESSURE FOR TUBES 35.75 Kg/cm<sup>2</sup>g AT NEW CONDITION & 35.75 Kg/cm<sup>2</sup>g AT OLD CONDITION.
- 33] HYDRO TEST SHALL BE CARRIED OUT AS FOLLOWS :-  
A) PRIOR TO ASSEMBLY OF CHANNEL COVER FROM SHELL SIDE AT A PRESSURE OF 35.75 Kg/cm<sup>2</sup>g.  
B) AFTER COMPLETE ASSEMBLY : i) FROM TUBE SIDE AT A PRESSURE OF 35.75 Kg/cm<sup>2</sup>g  
ii) SIMULTANEOUSLY FROM SHELL SIDE & TUBE SIDE AT A PRESSURE INDICATED IN DESIGN DATA.  
CAUTION :- THE DIFFERENTIAL HYDRO TEST PRESSURE BETWEEN SHELL SIDE & TUBE SIDE SHALL NOT BE ALLOWED TO EXCEED MORE THAN 35.75 Kg/cm<sup>2</sup>g AT ANY TIME DURING HYDROTEST.

- 34] SHELL SIDE AND TUBE SIDE WILL BE SUBJECTED TO STEAMING OUT AT 0.5 Kg/cm<sup>2</sup>g & 190°C
- 35] a) WNRTU NOZZLE FLANGES GASKET FINISH SHALL BE 63-125 AARH.  
b) WNRF NOZZLE FLANGES GASKET FINISH SHALL BE 125-250 AARH.
- 36] GASKET FACE TO BE MACHINED AFTER FINAL HEAT TREATMENT.
- 37] NO WELDING OR HEATING IS PERMITTED AFTER PWHT OPERATION.
- 38] STACKED EXCHANGERS (211-E-1E & 211-E-1F) SHALL BE HYDROTESTED IN STACKED CONDITION.
- 39] ALL FABRICATION TOLERANCES SHOULD BE AS PER TIL-MFC-WI-26 REV.0 PAGE 1 TO 10. UNLESS OTHERWISE SPECIFIED.

- 40] ALL CARBON STEEL MATERIALS IN CONTACT WITH SHELL SIDE AND TUBE SIDE FLUIDS SHALL MEET REQUIREMENTS SPECIFIED IN AXENS SPECIFICATION IN 42.0. SHELL SIDE AND TUBE SIDE CARBON STEEL MATERIALS SHALL ALSO COMPLY WITH HIC RESISTANT MATERIAL REQUIREMENTS AS PER AXENS SPECIFICATION IN 43.0
- 42] TORQUE TABLE (MAX. ALLOWABLE TORQUE) "AS BUILT DRAWING"  $\Delta$   
W.O. No. : 07-386  
EQUIP. NO. : 211-E-1F  
257  
TEMA INDIA LTD

ITEM No.	Kgf.m	Lbf.ft.
504	54.54	394.5
505	72.306	523
506	51.331	371.3

- 43] IMPACT TEST SHALL BE CARRIED OUT FOR PART NO. 101, 102, 205, 206, 115, 116, 201, 202, 203, 204, 211 TO 214 & 219 AT -29 °C.



SCALE	REV	SHT
NTS	3	2 of 18
DWG NO.	SDB/E/071204	

P.No.	DESCRIPTION	SIZE	MATERIAL SPECIFIED.	QTY	REMARK
302	SPACER	0021.4x2.65THKxL.G. AS PER TABLE	IS 1239	1	
301	'U' TUBES	0025x3.0THK(Min.)xL.G. AS PER TABLE	SA 179	647	
219	FORGE NECK FOR T1B & T2B	0D406.4xID363.52x483LG.	SA266 Gr.4	2	
218	PULLING EYE BOLT	M-36 AS PER DETAIL	SA 105	4	
217	PLUG FOR PULLING EYE BOLT	M-36 AS PER DETAIL	SA266 Gr.4	4	
216	SEAL RING FOR T2B	68THK AS PER DETAIL	SA266 Gr.4	1	
215	ADDED STEEL (PROPRIETARY)	-	-	1	
214	INNER COMPRESSION RING	0D1390xID1326x35THK	SA266 Gr.4	1	
213	OUTER COMPRESSION RING	0D1574xID1516x39.6THK	SA266 Gr.4	1	
212	INTERNAL FLANGE	0D1526.5xID1328x179THK	SA266 Gr.4	1	
211	SPLIT RING	0D1552xID1501x38THK	SA266 Gr.4	1	
210	COMPANION NOZZ. FLG. FOR T2B	400DNxSCH.80x600#WNRF	SA 105	1	
209	NOZZLE FLANGE FOR T1B & T2B	400DNxSCH.80x600#WNRF	SA 105	2	
208	COMPANION NOZZ. FLG. FOR S1B	350DNxSCH.100x900#WNRT	SA 105	1	
207	NOZZLE FLANGE FOR S1B & S2B	350DNxSCH.100x900#WNRT	SA 105	2	
206	FORGE NECK FOR S2B	0D493.5xID308x481LG.	SA266 Gr.4	1	(ID 317.5) Δ
205	FORGE NECK FOR S1B	0D493.5xID308x481LG.	SA266 Gr.4	1	(ID 317.5) Δ
204	CHANNEL COVER	φ1520.5x217THK	SA266 Gr.4	1	
203	THREADED LOCK RING	0D1612.21xID1469x290.83THK	SA266 Gr.4	1	
202	CHANNEL BARREL	AS PER DETAIL	SA266 Gr.4	1	
201	TUBE SHEET	0D1515x166THK	SA266 Gr.4	1	

P.No.	DESCRIPTION	SIZE	MATERIAL SPECIFIED.	QTY	REMARK
146	GUSSET FOR INNER CYLINDER	60x60x16THK	SA516 Gr.60	20	
145	WARNING PLATE BRACKET	8THK AS PER DETAIL	SA516 Gr.60	1	
144	NAME PLATE BRACKET	8THK AS PER DETAIL	SA516 Gr.60	1	
143	PL. FOR LIFTING DEVICE	30THK (32THK) ASPER DETAIL Δ	SA516 Gr.70	1	
142	PL. FOR LIFTING DEVICE	30THK (32THK) ASPER DETAIL Δ	SA516 Gr.70	1	
141	EARTHING CLEAT	100x75x10THK	SA516 Gr.60	2	
140	SHIM PLATE FOR FIXED SADD. SIDE	1890x350x THK TO SUIT	SA516 Gr.60	1	
139	SHIM PLATE FOR SLIDING SADD. SIDE	2090x350x THK TO SUIT	SA516 Gr.60	1	
138	RIB PL. FOR SLIDING SADD. SUPP.	2432x330x20THK	SA516 Gr.60	2	
137	RIB PL. FOR FIXED SADD. SUPP. FOR TOP	564x159x20THK	SA516 Gr.60	4	
136	RIB PL. FOR FIXED SADD. SUPP. FOR TOP	775x155x20THK	SA516 Gr.60	4	
135	RIB PL. FOR FIXED SADD. SUPP. FOR BTM.	252x155x20THK	SA516 Gr.60	4	
134	RIB PL. FOR FIXED SADD. SUPP. FOR BTM.	462x155x20THK	SA516 Gr.60	4	
133	WEAR PL. FOR FIXED SADD. SUPP.	1820x2432x20THK	SA516 Gr.60	1	
132	WEAR PL. FOR FIXED SADD. SUPP.	5168° x350x20THK	SA516 Gr.60	1	
131	BASE PL. FOR FIXED SADD. SUPP. FOR TOP	1890x350x25THK	SA516 Gr.60	1	
130	BASE PL. FOR FIXED SADD. SUPP. FOR BTM.	1890x350x40THK	SA516 Gr.60	1	
129	RIB PL. FOR SLIDING SADD. SUPP.	2432x330x20THK	SA516 Gr.60	2	
128	RIB PL. FOR SLIDING SADD. SUPP. FOR TOP	437x155x20THK	SA516 Gr.60	4	
127	RIB PL. FOR SLIDING SADD. SUPP. FOR TOP	691x155x20THK	SA516 Gr.60	4	
126	RIB PL. FOR SLIDING SADD. SUPP. FOR BTM.	124x155x20THK	SA516 Gr.60	4	
125	RIB PL. FOR SLIDING SADD. SUPP. FOR BTM.	381x155x20THK	SA516 Gr.60	4	
124	WEAR PL. FOR SLIDING SADD. SUPP.	2020x2432x20THK	SA516 Gr.60	1	
123	WEAR PL. FOR SLIDING SADD. SUPP.	6007° x350x20THK	SA516 Gr.60	1	
122	BASE PL. FOR SLIDING SADD. SUPP. FOR TOP	2090x350x25THK	SA516 Gr.60	1	
121	BASE PL. FOR SLIDING SADD. SUPP. FOR BTM.	2090x350x40THK	SA516 Gr.60	1	
120	GASKET RETAINER	φ1557x20THK	SA240 Gr.321	1+1	
119	INTERNAL SLEEVE	4266° x877x30THK Δ	SA516 Gr.60	1	
118	RETAINING RING FOR T2B	0D437.7xID413.7x3THK	SA240 Gr.321	1	
117	PARTITION COVER PLATE	32THK AS PER DETAIL Δ	SA516 Gr.60	1	
116	END PLATE	0D1515x26THK	SA516 Gr.60	1	
115	PLATE FOR INTERNAL CYLINDER	4672° x734x28THK Δ	SA516 Gr.60	1	
114	PASS PARTITION PLATE	1459x734x36THK Δ	SA516 Gr.60	1	
113	SEALING STRIP	5814x60Wx8THK	SA516 Gr.60	2	
112	SEALING STRIP	3666x150Wx8THK	SA516 Gr.60	2	
111	SEALING STRIP	4166x150Wx8THK	SA516 Gr.60	2	
110	SUPPORT PLATE 'C'	5814x70Wx20THK	SA516 Gr.60	2	
109	PARTIAL SUPPORT PLATE 'S1'	16THK AS PER DETAIL	SA516 Gr.60	1	
108	PARTIAL SUPPORT PLATE 'S'	16THK AS PER DETAIL	SA516 Gr.60	1	
107	PARTIAL SUPPORT PLATE 'S'	16THK AS PER DETAIL	SA516 Gr.60	1	
106	BAFFLE PLATE 'D'	16THK AS PER DETAIL	SA516 Gr.60	1	
105	BAFFLE PLATE 'B'	16THK AS PER DETAIL	SA516 Gr.60	5	
104	BAFFLE PLATE 'A1'	16THK AS PER DETAIL	SA516 Gr.60	1	
103	BAFFLE PLATE 'A'	16THK AS PER DETAIL	SA516 Gr.60	4	
102	HEMI HEAD DISHED END	45THK Norm.	SA516 Gr.60	1	
101	MAIN SHELL	4869° x565.3x75THK	SA516 Gr.60	1	

**PLATES**

**BILL OF MATERIALS**

258

**TEMA**  
INDIA LTD.

Revised

W.O. No. : 07-386

ENGR. SUBESH KUMAR


DESIGN NO. : 211-E-1F

SCALE NTS

REV 3

SHT 3 of 18



DWG NO. SDB/E/071.204

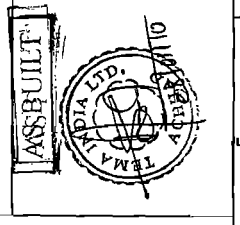

P.No.	DESCRIPTION	SIZE	MATERIAL SPECIFIED.	QTY	REMARK
<b>MISCELLANEOUS</b>					
610	ASME NAME PLATE	175x120x2THK	SAI 304	1	
609	WARNING PLATE	155x155x2THK	SAI 304	1	
608	NAME PLATE	150x136x2THK	SAI 304	1	
607	HANDLE FOR PARTITION COVER	ø16x350LG.	SA516 Gr.60	2	
606	SEAL ROD	ø25x4116LG.	IS 2062	46	
605	PUSH ROD	ø25x119LG.	SA193 Gr.B16	76+76	
604	PUSH ROD	ø22x275LG.	SA193 Gr.B16	92+92	
603	PUSH ROD	ø25x148LG.	SA453 Gr.660B	84+80	
602	IMPINGEMENT ROD	ø25x1200LG.	IS 2062	27	
601	TIE ROD	ø12x5837LG.	IS 2062	22	
<b>FASTENERS</b>					
513	STUD-2NUTS FOR T2B COMP. FLG.	1½" UNBx290 LG.	SA193 Gr.B7	20+4	
512	STUD-2NUTS FOR S1B COMP. FLG.	1½" UNBx315 LG.	SA194 Gr.2H	20+4	
511	BOLT WITH NUT & WASHER FOR SADDLE SUPP.	M-42x140 LG.	SA193 Gr.B7/SA194 Gr.2H	16	
510	STUD-2NUTS FOR NOZZ. T2A & T1B	1½" UNBx290 LG.	SA193 Gr.B7	20+4	
509	STUD-2NUTS FOR NOZZ. S1A & S2B	1½" UNBx315 LG.	SA194 Gr.2H	20+4	
508	HEX. HD. BOLT FOR LIFTING DEVICE	M-24x68LG.	SA193 Gr.B7	4	
507	HEX. SOCKET SET SCREW	M-10x25 LG.	SA193 Gr.B8T CL.2	3	
506	HEX. HD. BOLT (SET SCREW)	1½" UNBx89 LG.	SA453 Gr 660B	80	
505	HEX. HD. BOLT (SET SCREW)	1" UNBx82 LG.	SA193 Gr B16	92	
504	HEX. HD. BOLT (SET SCREW)	1½" UNBx89 LG.	SA193 Gr. B16	76	
503	NUTS FOR TIE RODS	M-12 STD.	SA194 Gr. 8T	44	
502	STUD WITH INT'L-FLAT WASHER & 1-LOCK WASHER	M-12x78LG.	SA193 Gr.B8T CL.2+	52	
501	HEX. HD.SCREW WITH LOCKNUT	M-10x45 LG.	SA194 Gr.8T	28	
<b>GASKETS</b>					
409	GASKET FOR T2B COMP. FLG.	400DNx600#x4.5THK	SAI 304 SPWD	1+4+2	
408	GASKET FOR S1B COMP. FLG.	350DNx900# ASME RING No.62	SOFT IRON	1+4+2	PROGRESS SERIAL NO. COCZAG000L RING
407	GASKET FOR T2A & T1B	400DNx600#x4.5THK	SAI 304 SPWD	1+4+2	
406	GASKET FOR S1A & S2B	350DNx900# ASME RING No.62	SOFT IRON	1+4+2	PROGRESS SERIAL NO. COCZAG000L RING
405	PACKING SEAL FOR T2B	12.750x3000LG.	FIBER GLASS UJP-329	1+4+2	
404	GASKET FOR PARTITION PLATE	3THK (AS PER DETAIL)	NON ASPEROS WITH RAUBUE FIBRE	1+4+2	
403	RING GASKET	OD1558xID1538x3THK	SA240 Gr.321	1+4+2	
402	GASKET	OD1515xID1460.8x1.6THK	SA240 Gr.321	1+4+2	
401	GASKET	OD1507xID1481x6.35THK	SAI 321 SPWD	1+4+2	SEE NOTE-16

**BILL OF MATERIALS**

AS BUILT

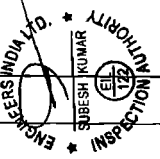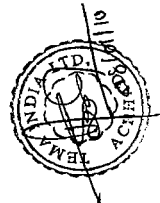


*Revised*  
*Kumar*  
 08/10/2010

AS BUILT DRAWING

W.O. No. : 07-386  
 EQPT. NO. : 211-E-1F

259  
 TEMA  
 INDIA LTD.

SCALE	REY	SHT
NTS	3	4 of 18
DWG NO. SDB/E/071204		

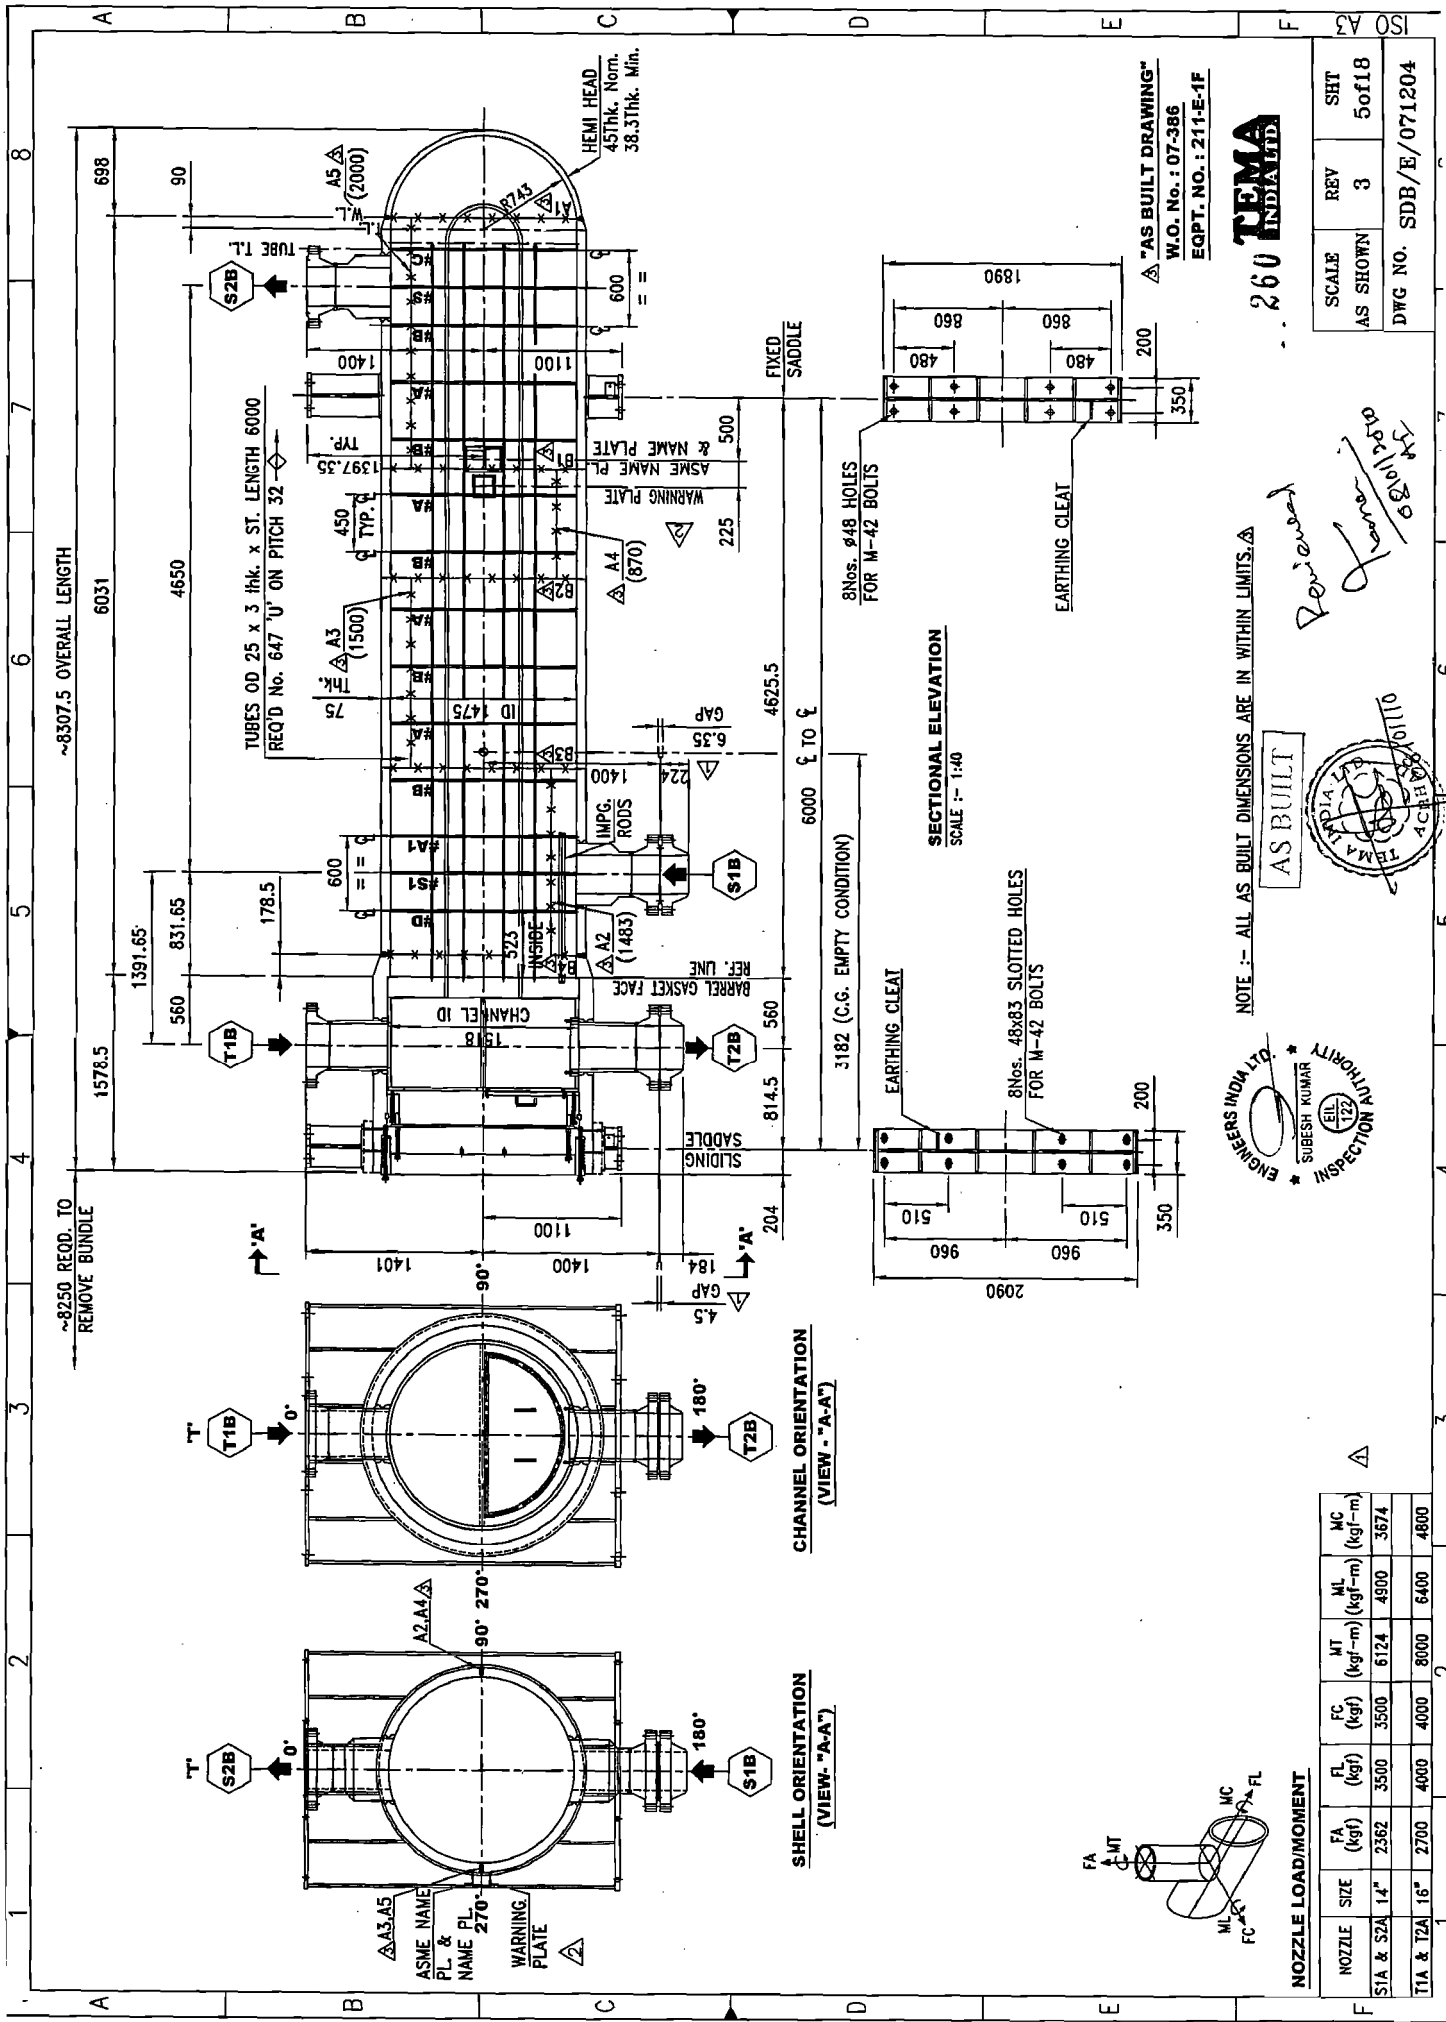

SCALE	REV	SHT
AS SHOWN	3	5 of 18
DWG NO. SDB/E/071204		


260  
TEMA  
INDIA LTD.

"AS BUILT DRAWING"  
W.O. No. : 07-386  
EQPT. NO. : 211-E-1F

NOTE :- ALL AS BUILT DIMENSIONS ARE IN WITHIN LIMITS. Δ


AS BUILT

ENGINEERS' INDIA LTD.  
SUBESH KUMAR  
INDIA  
23/11/2010






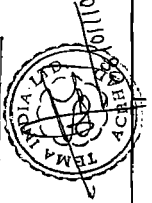


NOZZLE LOAD/MOMENT

NOZZLE	SIZE	FA (kgf)	FL (kgf)	FC (kgf)	MT (kgf-m)	ML (kgf-m)	MC (kgf-m)
S1A & S2A	14"	2362	3500	3500	6124	4900	3674
T1A & T2A	16"	2700	4000	4000	8000	6400	4800

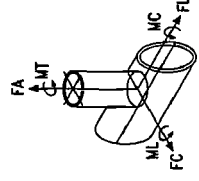



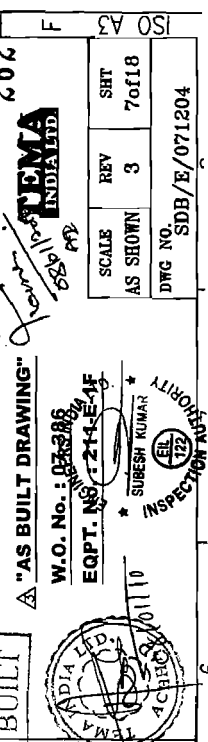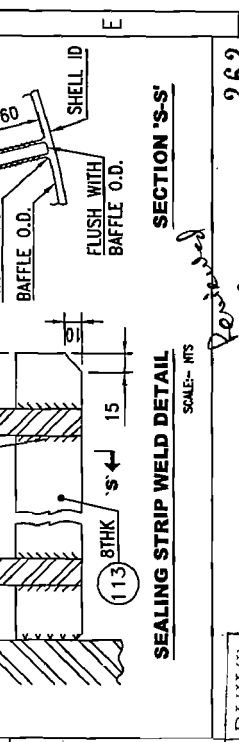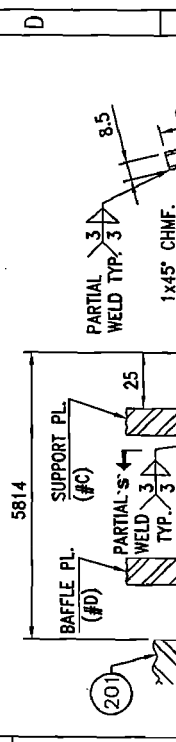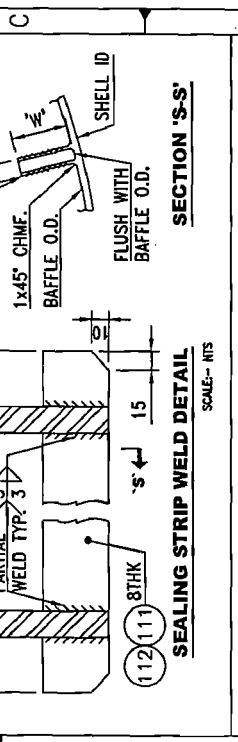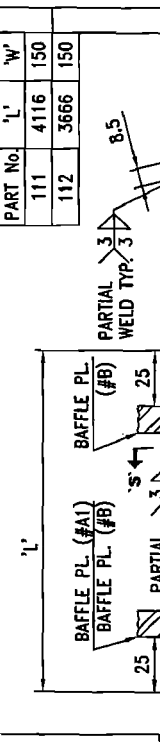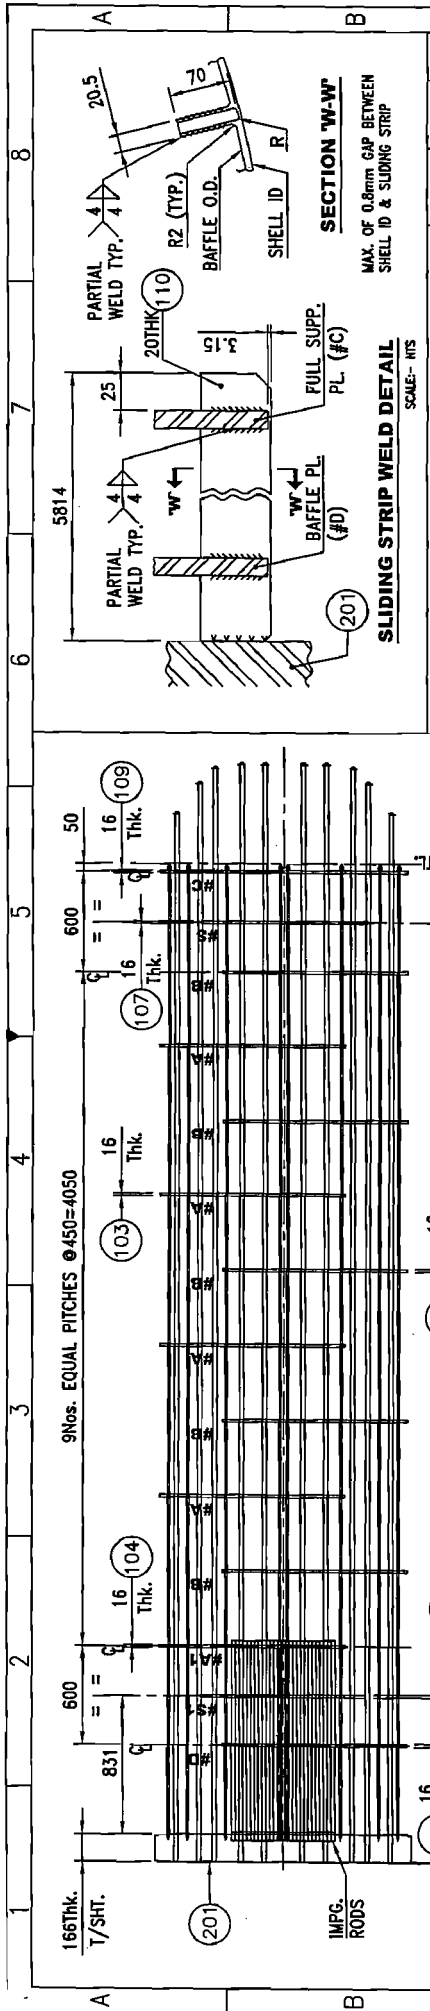

**SPACER TUBE**





SCALE: NTS

IT.NO	LENGTH	QTY.
302A	523	14
302B	1123	8
302C	284	24
302D	434	126
302E	884	32
302F	584	16
302G	1034	8

**PLUG**

SCALE: NTS

54	28
92	92

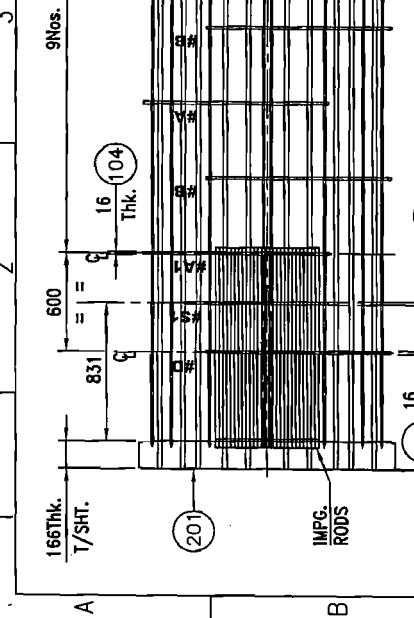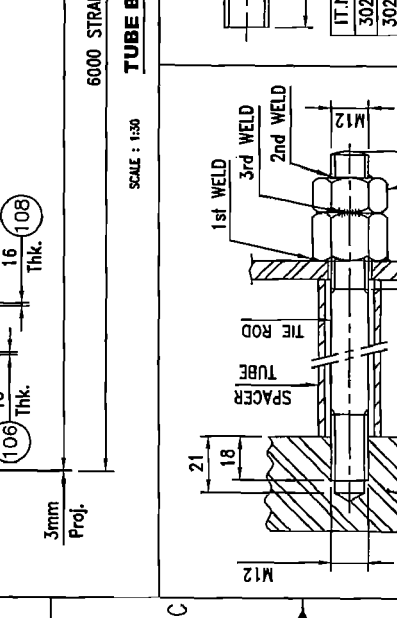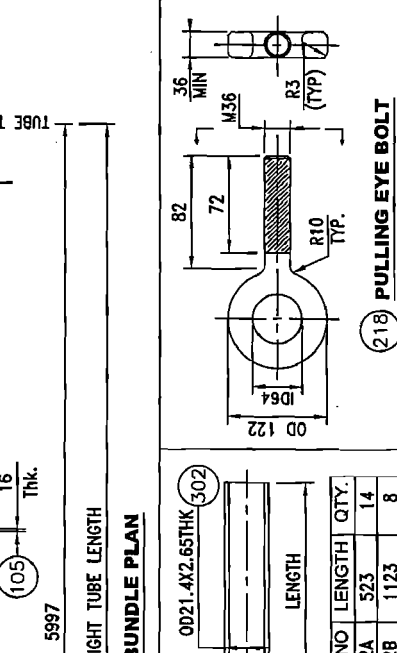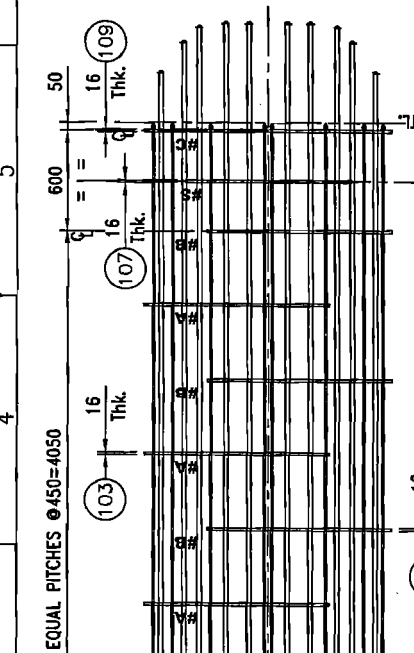

**PART No. 'L' 'W'**

111	4116	150
112	3666	150

**AS BUILT**

W.O. No.: 03-286

EQPT. NO.: 214-E-9F

SUBSH KUMAR

INSPECTOR

AS BUILT DRAWING

262


TEMA INDIA LTD

SCALE AS SHOWN


REV 3

SHT 7 of 18

DWG NO. SDB/E/071204

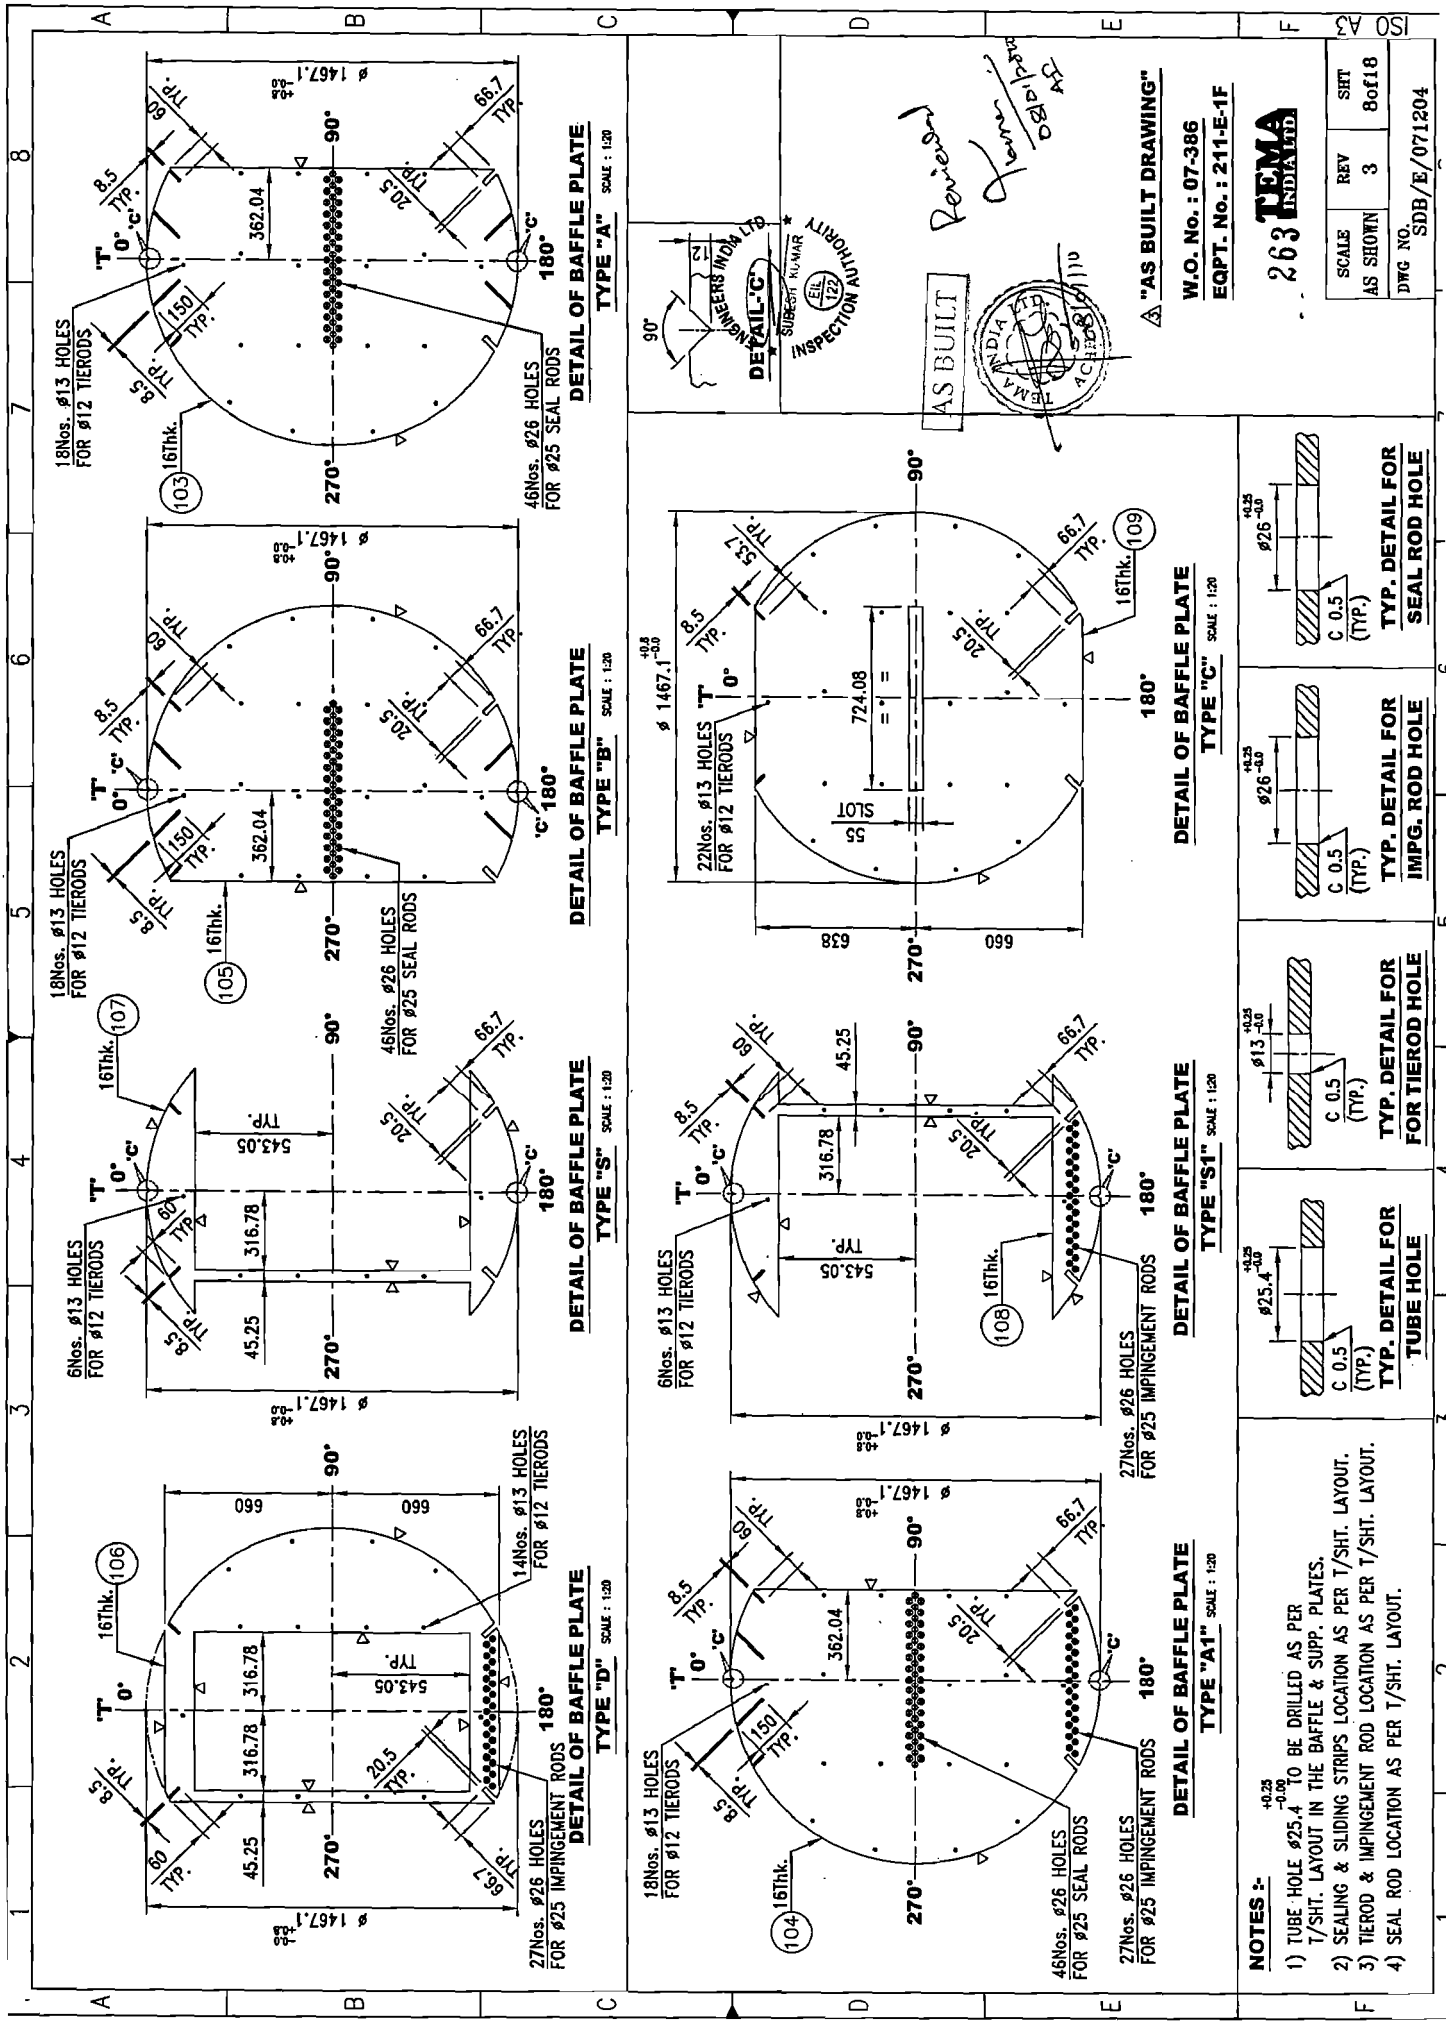

- NOTES :-**
- 1) TUBE HOLE  $\phi 25.4^{+0.25}_{-0.00}$  TO BE DRILLED AS PER T/SHT. LAYOUT IN THE BAFFLE & SUPP. PLATES.
  - 2) SEALING & SLIDING STRIPS LOCATION AS PER T/SHT. LAYOUT.
  - 3) TIEROD & IMPINGEMENT ROD LOCATION AS PER T/SHT. LAYOUT.
  - 4) SEAL ROD LOCATION AS PER T/SHT. LAYOUT.

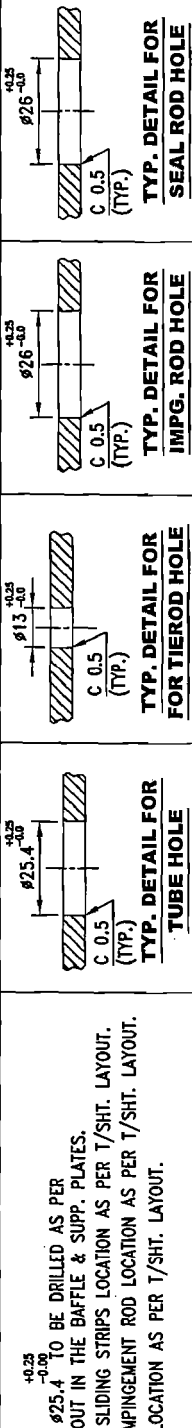


SCALE	REV	SHT
AS SHOWN	3	8 of 18

DWG. NO. SDB/E/071204

W.O. No. : 07-386  
EQPT. No. : 211-E-1F

**TEMA INDIA LTD**  
263

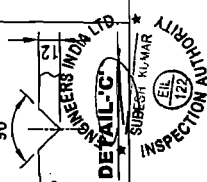

18Nos. #13 HOLES FOR #12 TIERODS  
46Nos. #26 HOLES FOR #25 SEAL RODS  
180°  
270°  
90°  
1467.1  
362.04  
8.5  
150  
20.5  
66.7  
16Thk.  
103

18Nos. #13 HOLES FOR #12 TIERODS  
46Nos. #26 HOLES FOR #25 SEAL RODS  
180°  
270°  
90°  
1467.1  
362.04  
8.5  
150  
20.5  
66.7  
16Thk.  
105

6Nos. #13 HOLES FOR #12 TIERODS  
46Nos. #26 HOLES FOR #25 SEAL RODS  
180°  
270°  
90°  
1467.1  
543.05  
316.78  
45.25  
8.5  
150  
20.5  
66.7  
16Thk.  
107


27Nos. #26 HOLES FOR #25 IMPINGEMENT RODS  
14Nos. #13 HOLES FOR #12 TIERODS  
180°  
270°  
90°  
1467.1  
543.05  
316.78  
45.25  
8.5  
150  
20.5  
66.7  
16Thk.  
106

22Nos. #13 HOLES FOR #12 TIERODS  
46Nos. #26 HOLES FOR #25 SEAL RODS  
180°  
270°  
90°  
1467.1  
724.08  
8.5  
150  
20.5  
66.7  
16Thk.  
109

6Nos. #13 HOLES FOR #12 TIERODS  
27Nos. #26 HOLES FOR #25 IMPINGEMENT RODS  
180°  
270°  
90°  
1467.1  
543.05  
316.78  
45.25  
8.5  
150  
20.5  
66.7  
16Thk.  
108

18Nos. #13 HOLES FOR #12 TIERODS  
46Nos. #26 HOLES FOR #25 IMPINGEMENT RODS  
27Nos. #26 HOLES FOR #25 IMPINGEMENT RODS  
180°  
270°  
90°  
1467.1  
362.04  
8.5  
150  
20.5  
66.7  
16Thk.  
104



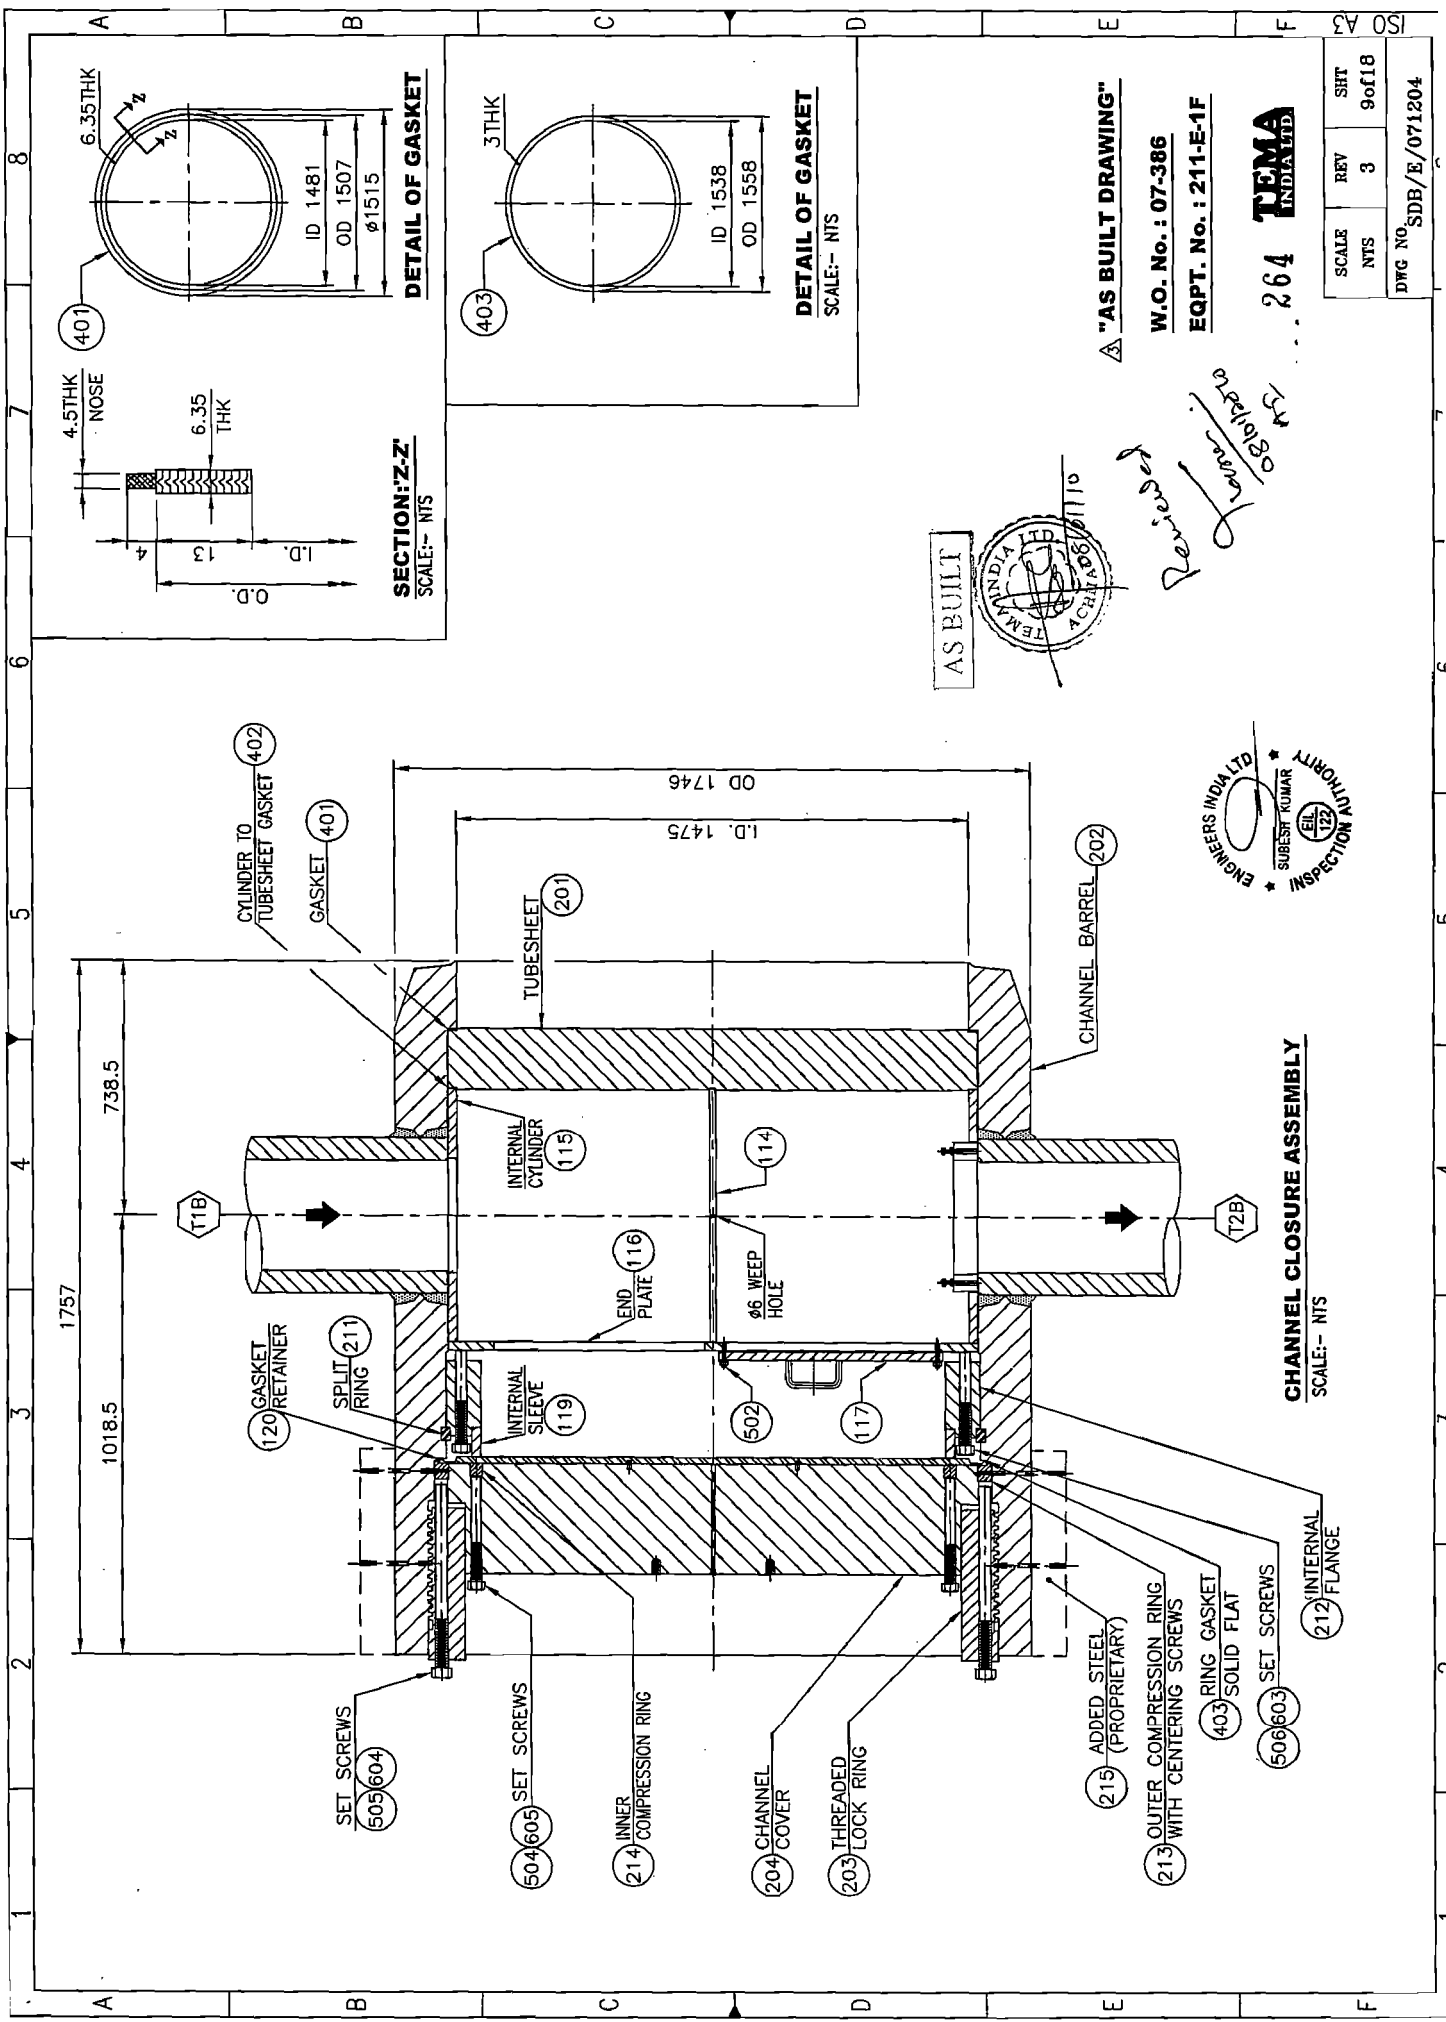

**DETAIL OF GASKET**  
SCALE:- NTS

**DETAIL OF GASKET**  
SCALE:- NTS

**SECTION:-Z-Z**  
SCALE:- NTS

**CHANNEL CLOSURE ASSEMBLY**  
SCALE:- NTS


"AS BUILT DRAWING"

W.O. No. : 07-386


EQPT. No. : 211-E-1F

264 TEMA INDIA LTD


AS BUILT

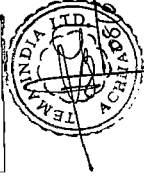


*Reminded*  
*02/01/2010*

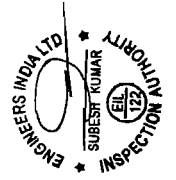

SCALE	REV	SHT
NTS	3	9 of 18
DWG NO. SDB/E/071204		

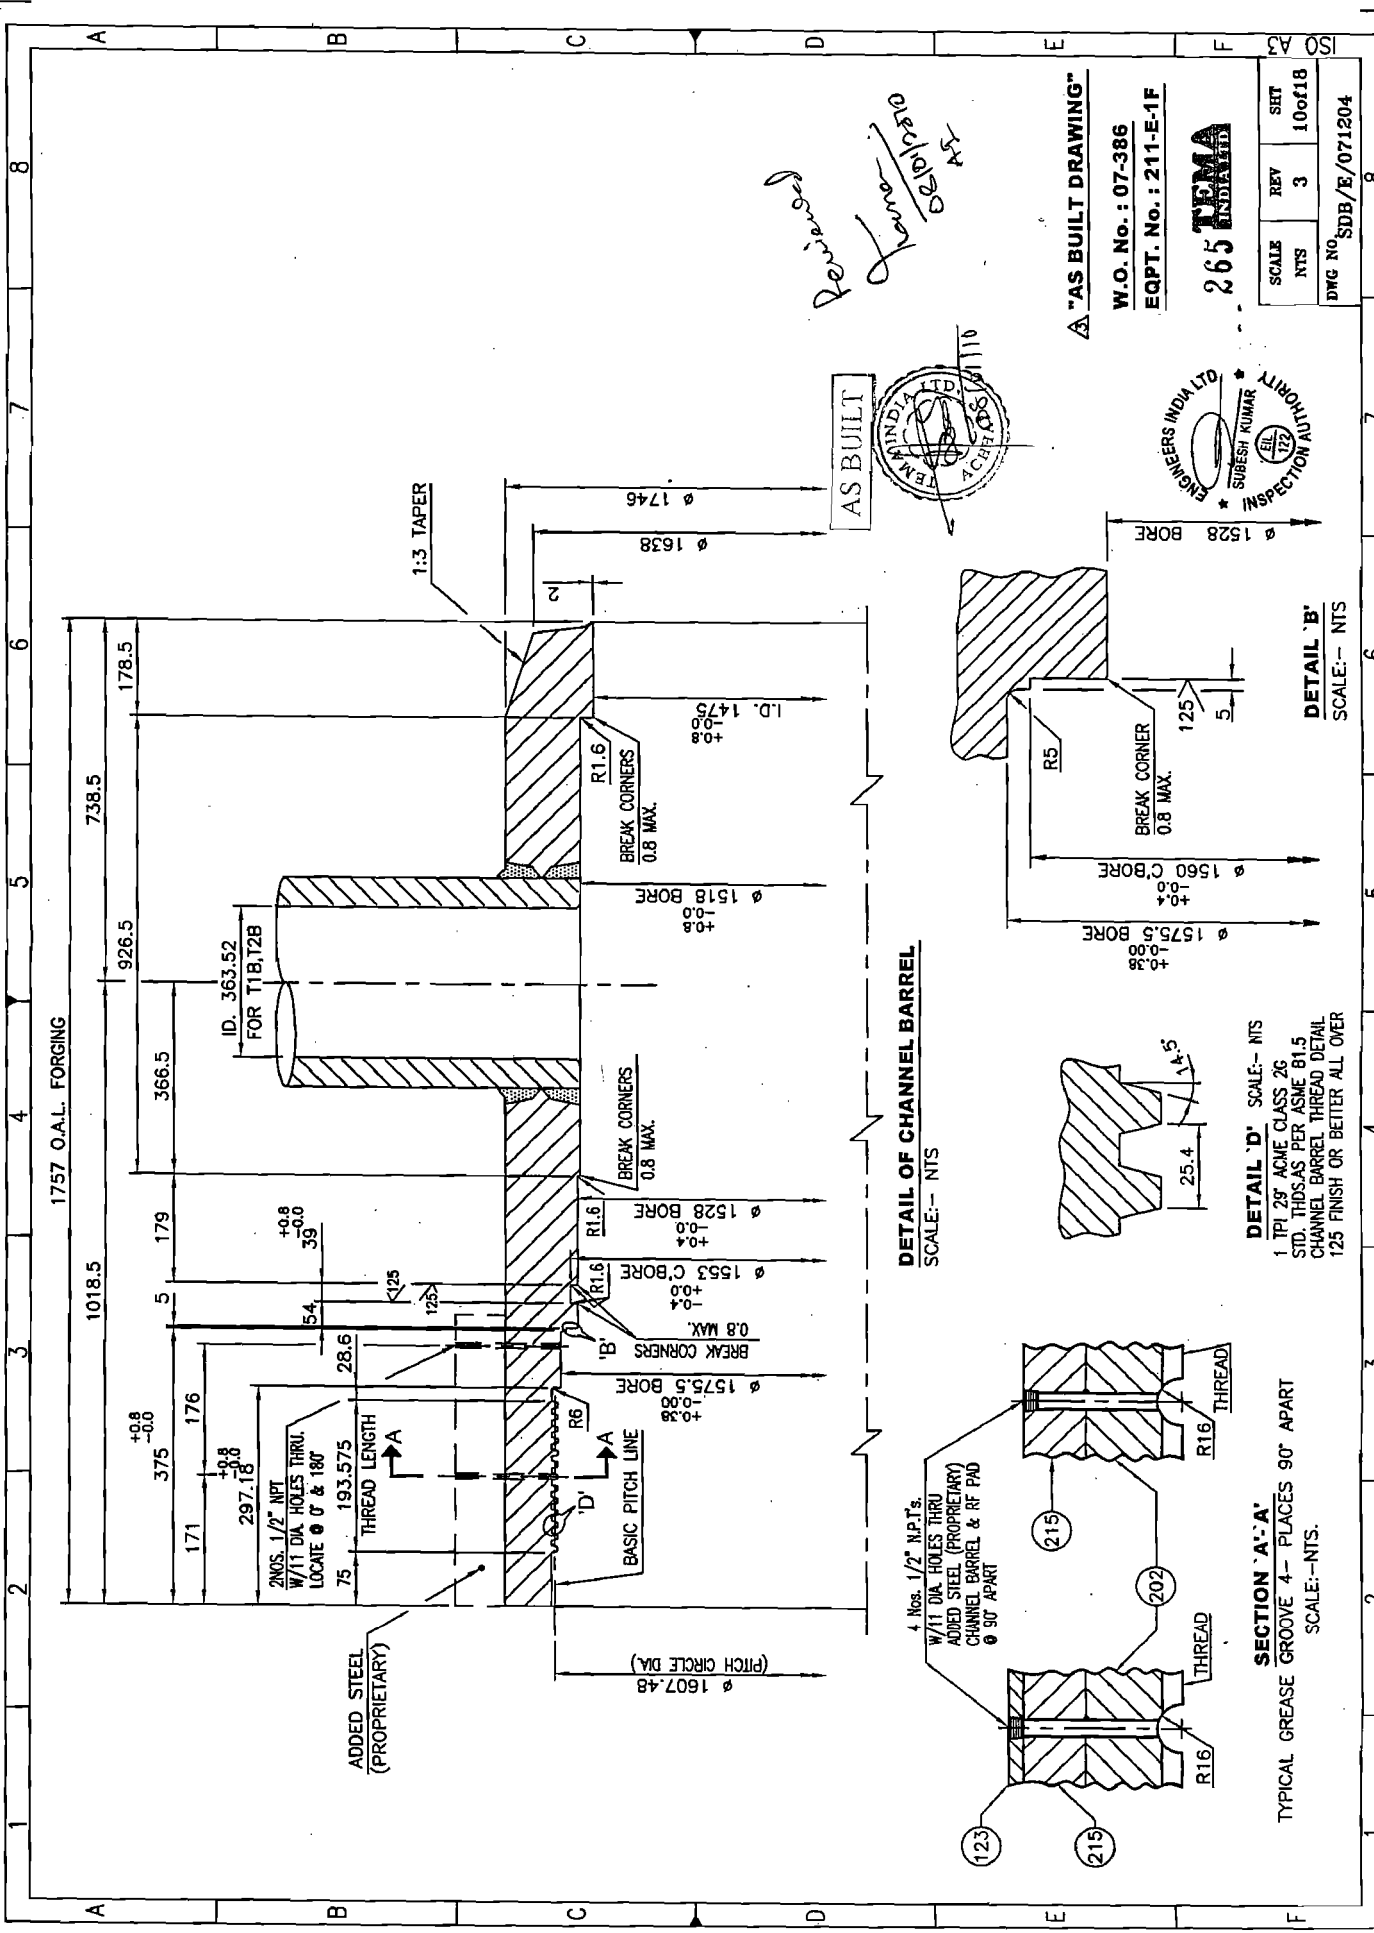

*Remainder  
Done  
08/10/2010  
AS*

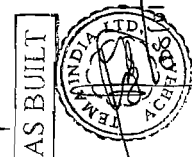

**"AS BUILT DRAWING"**

W.O. No. : 07-386  
EQPT. No. : 211-E-1F

**265 TEMA**  
INDIA LTD


SCALE	REV	SHT
NTS	3	10 of 18

DWG No. SDB/E/071204

**DETAIL OF CHANNEL BARREL**  
SCALE:- NTS

**DETAIL 'D'** SCALE:- NTS  
1 TPI 29° ACME CLASS 2G  
STD. THDS AS PER ASME B1.5  
CHANNEL BARREL THREAD DETAIL  
125 FINISH OR BETTER ALL OVER

**SECTION 'A-A'**  
TYPICAL GREASE GROOVE 4- PLACES 90° APART  
SCALE:-NTS.

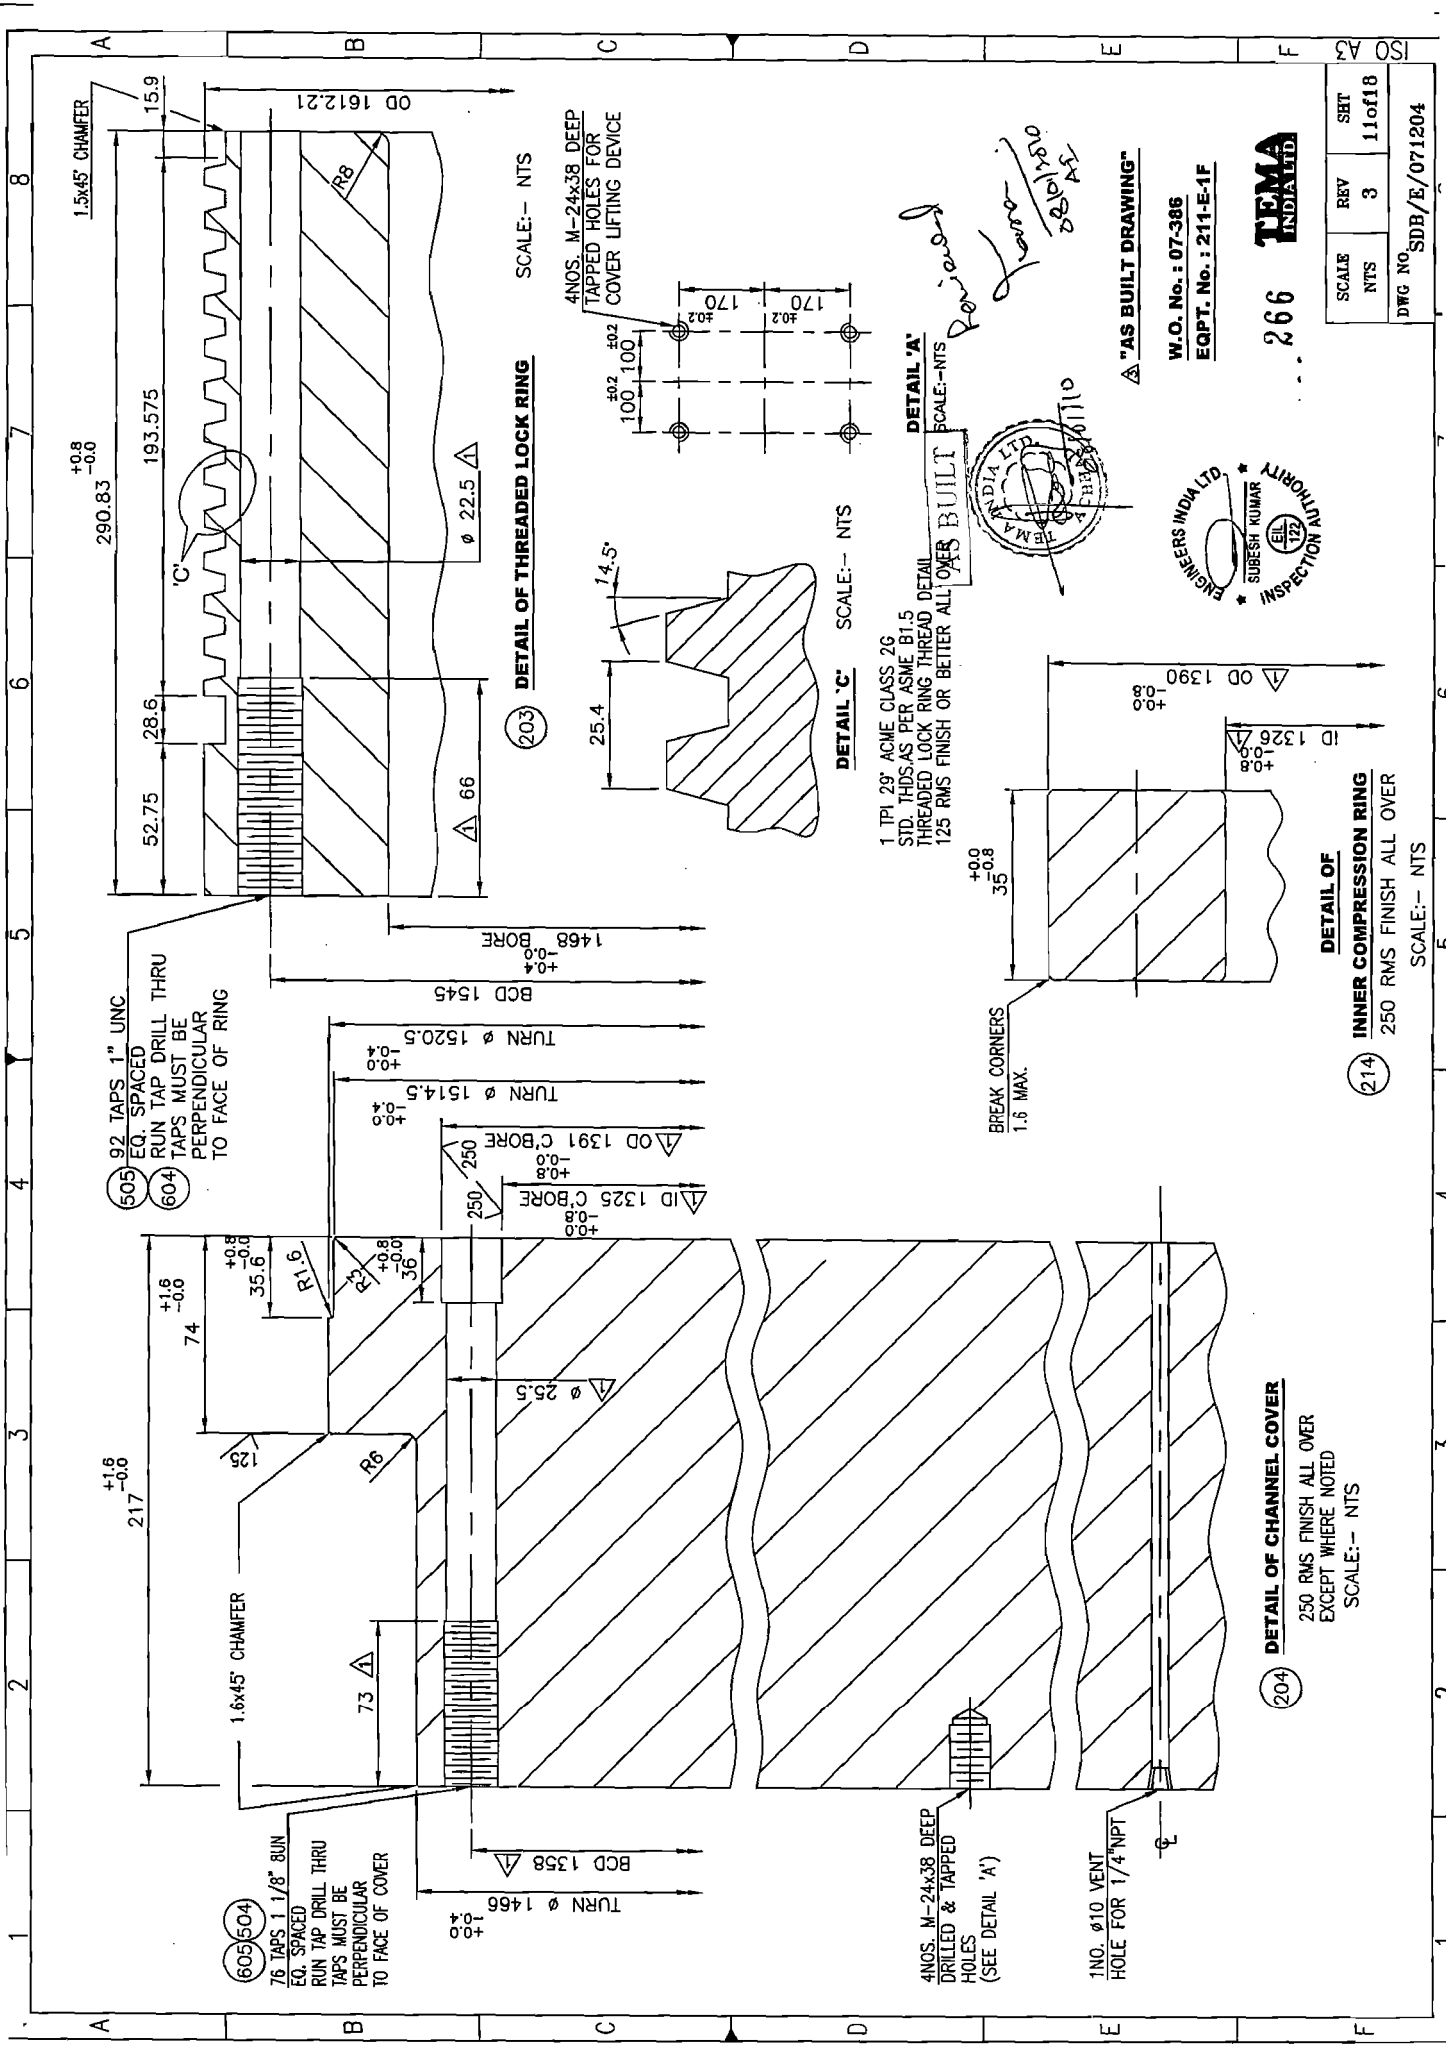


"AS BUILT DRAWING"


W.O. No. : 07-386  
EQPT. No. : 211-E-1F

266  
TEMA INDIA LTD

SCALE	REV	SET
NTS	3	11 of 18
DWG NO SDB/E/071204		



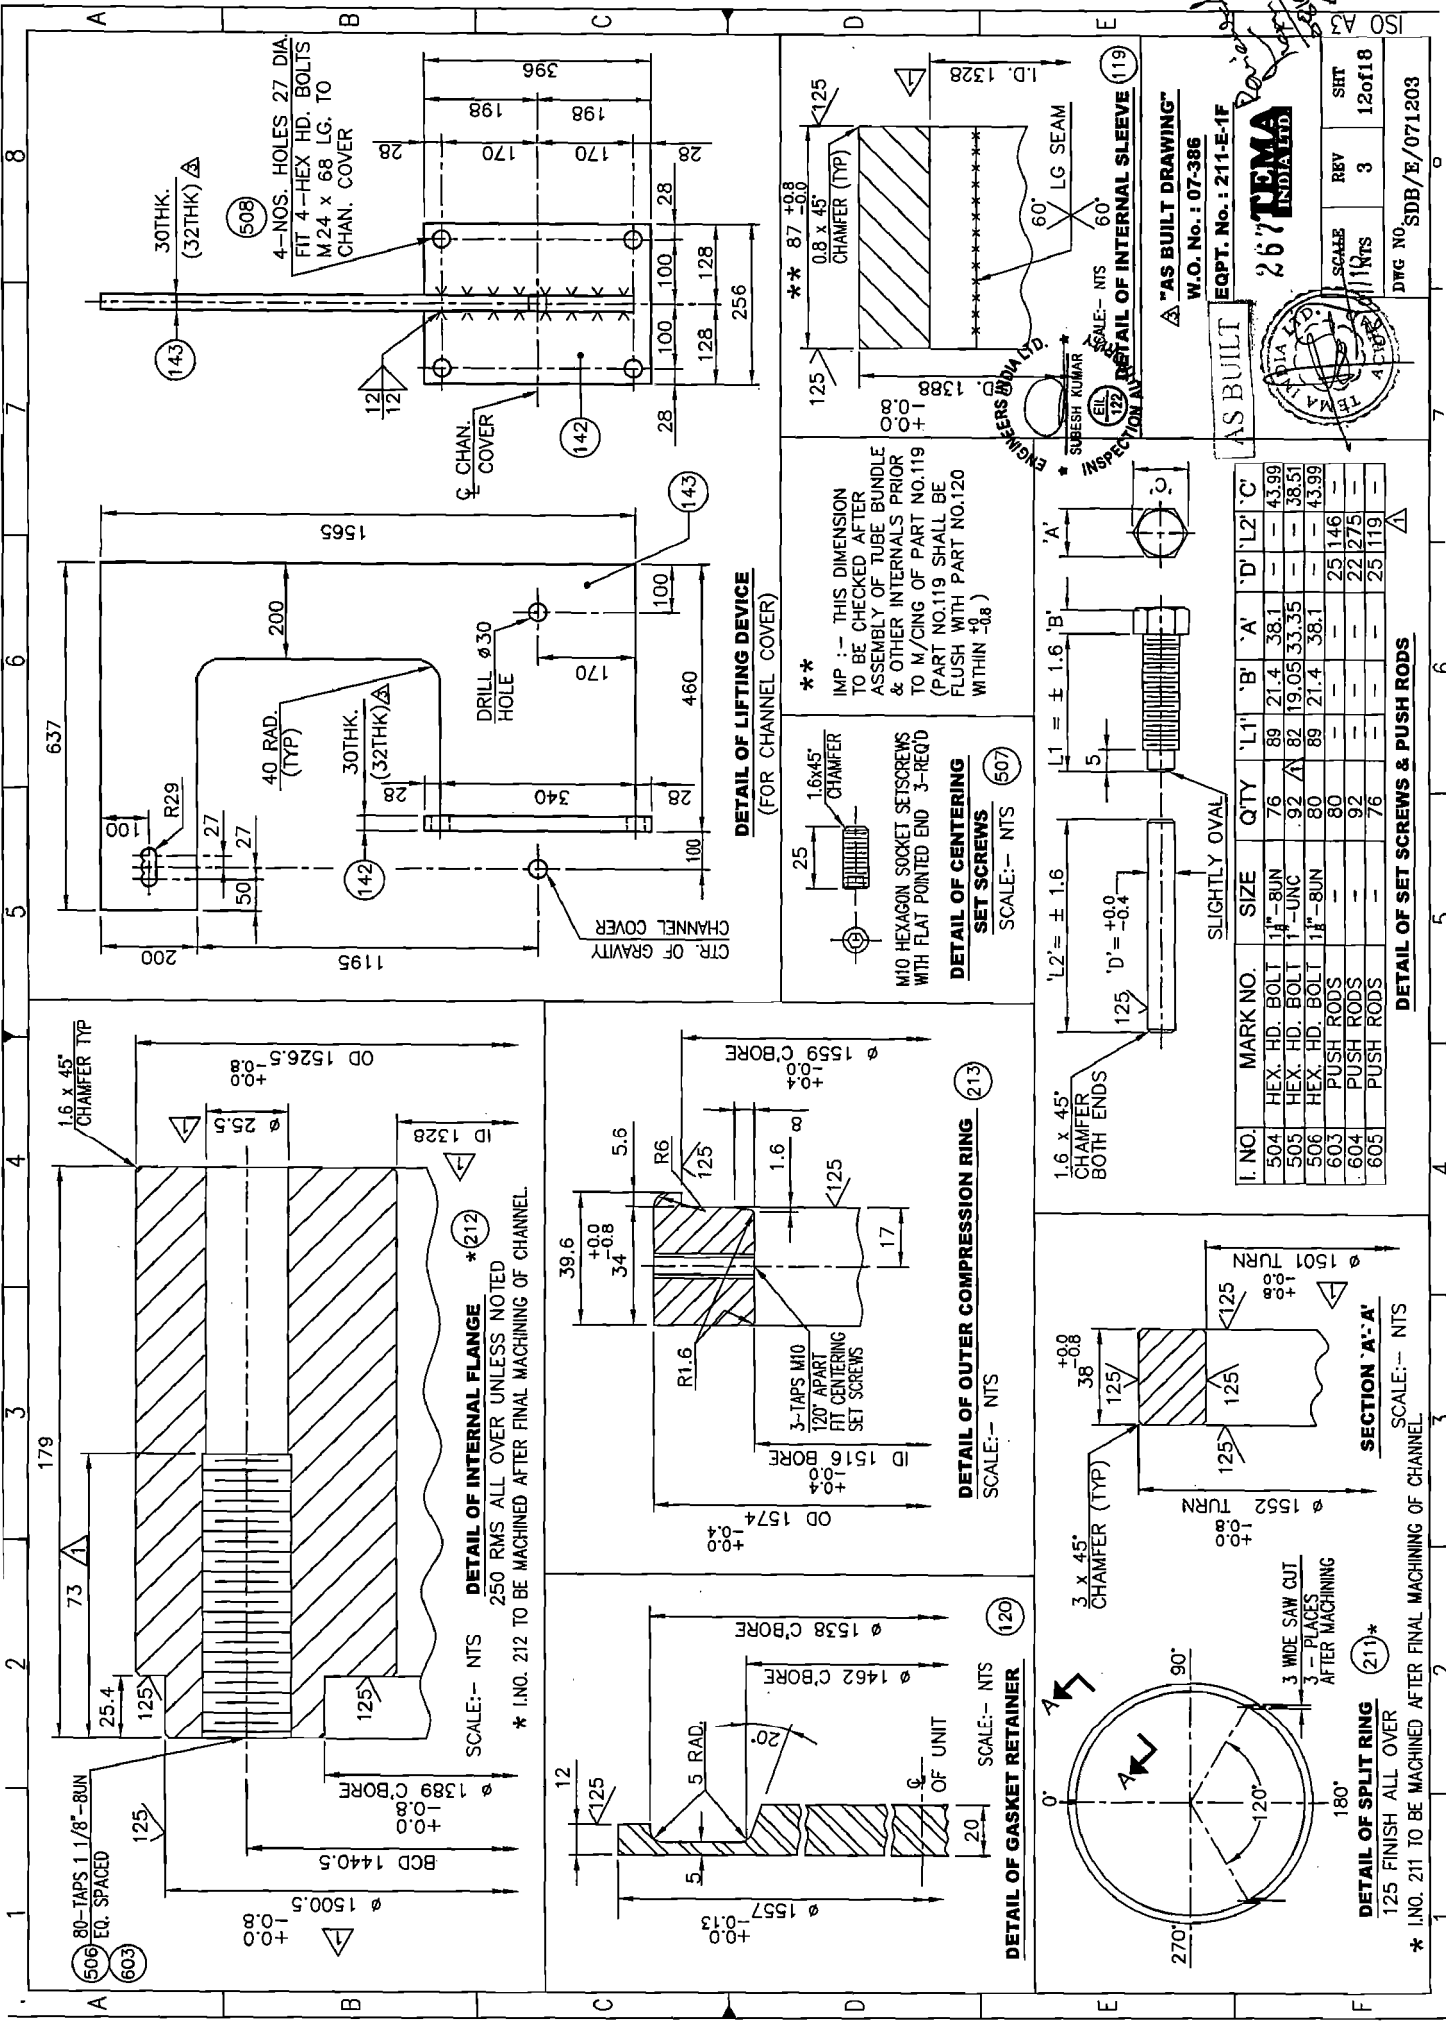

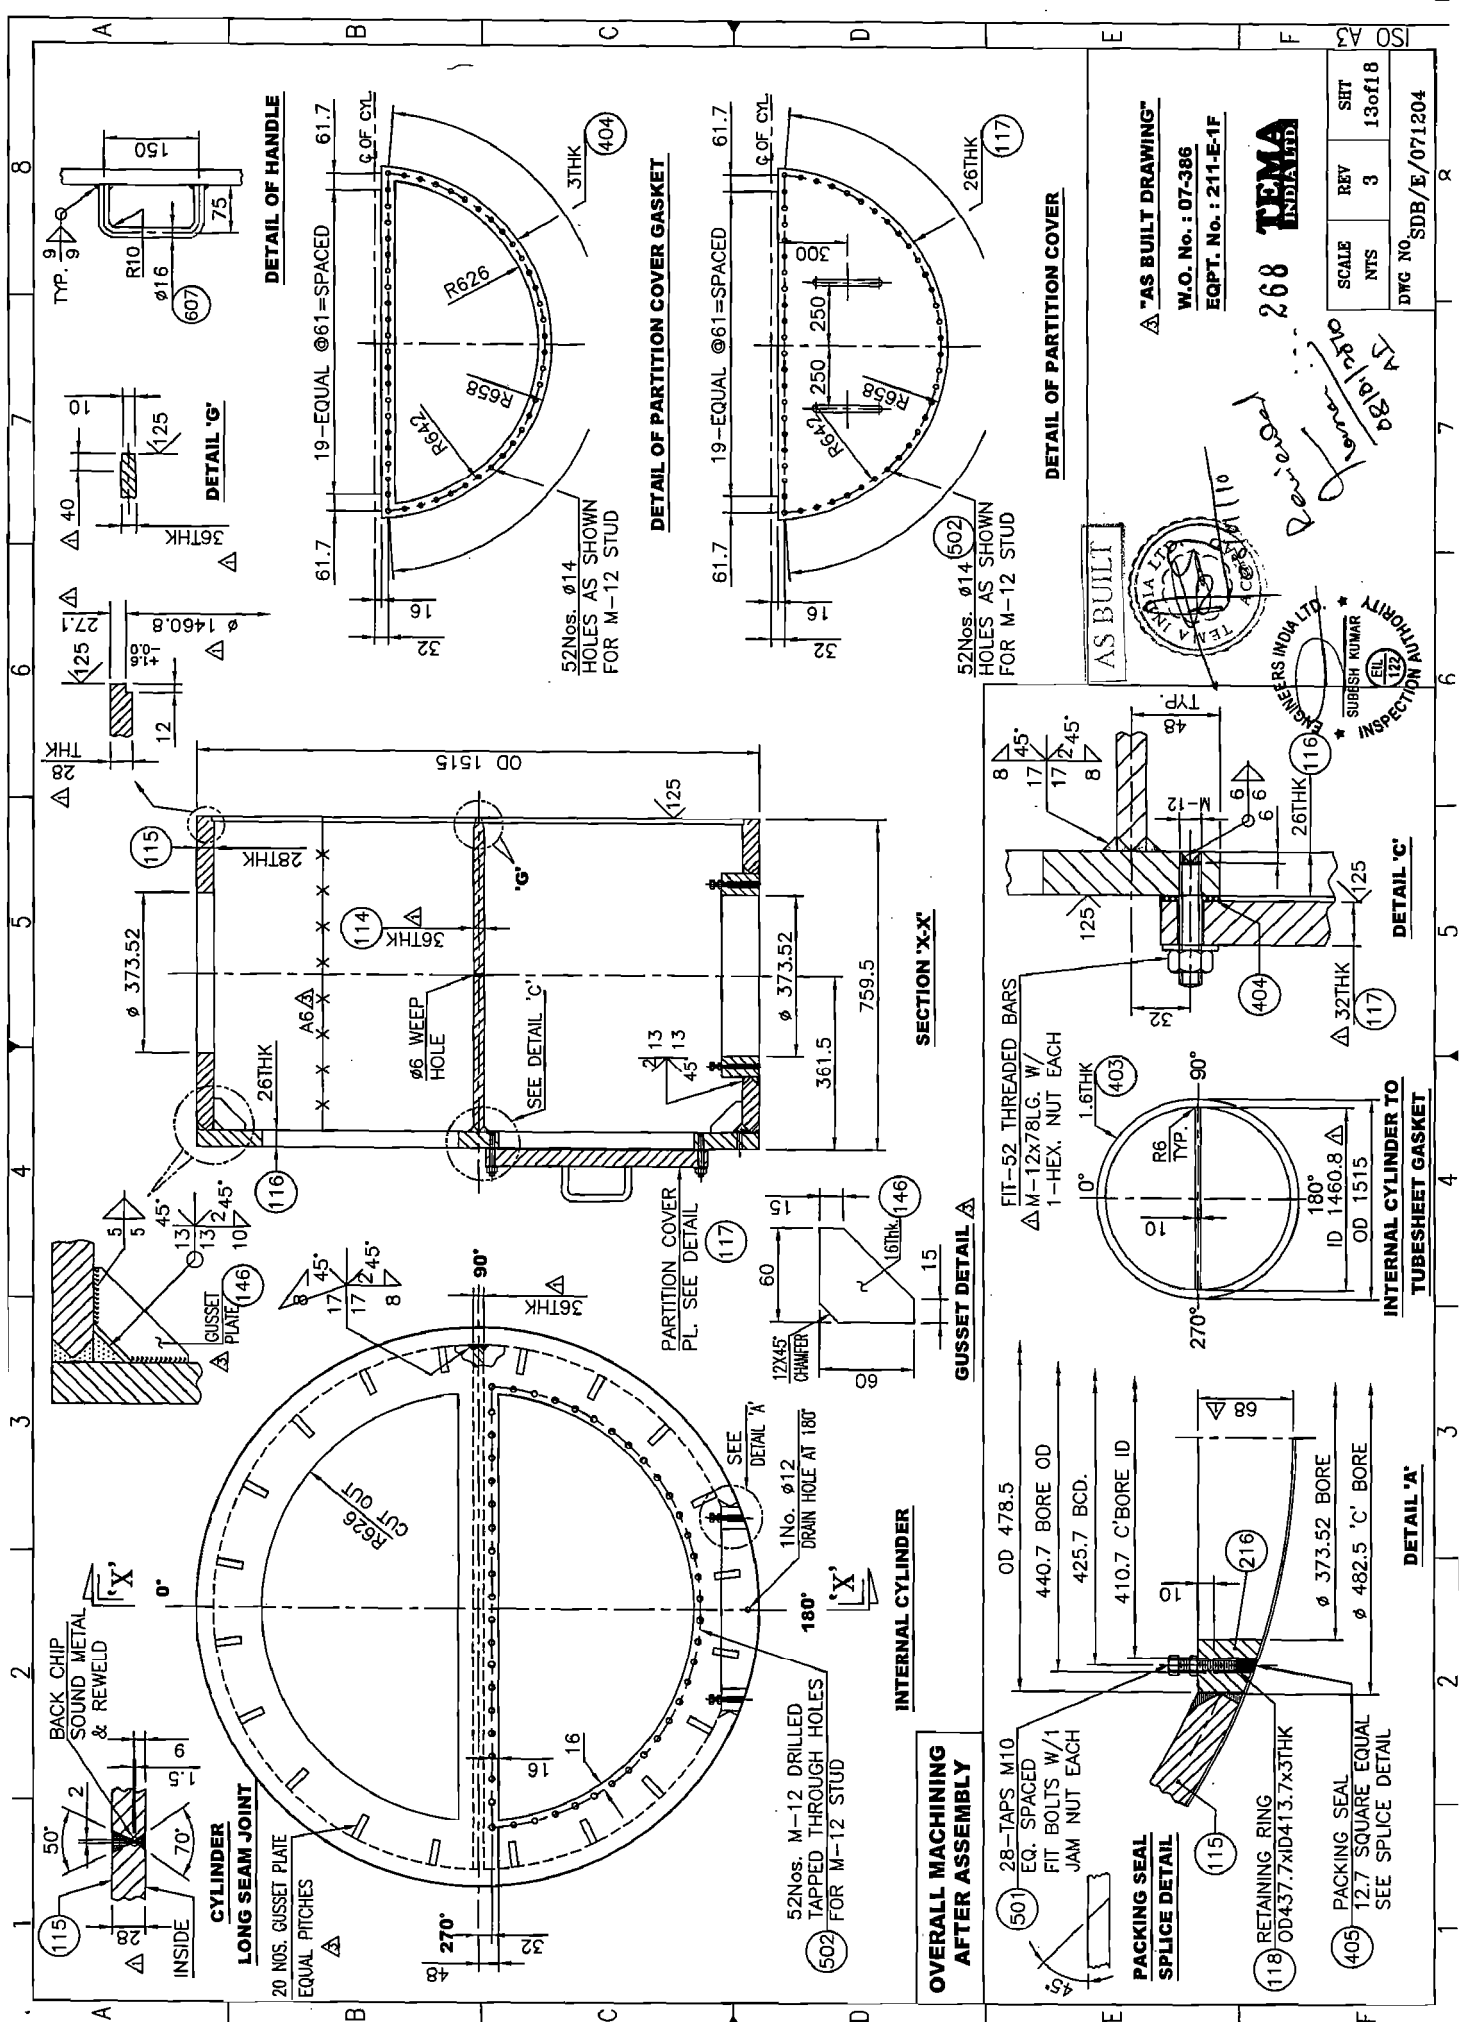


**AS BUILT DRAWING**  
 W.O. No. : 07-386  
 EQPT. No. : 211-E-1F  
 268  
**TEMA**  
 INDIA LTD.

APR 18/2010  
 J. Venkatesh  
 J. Venkatesh  
 J. Venkatesh

**INSPECTION AUTHORITY**  
 SUBISH KUMAR  
 122

**ENGINEERS INDIA LTD.**  
 110

SCALE NTS 3 13of18  
 DWG NO SDB/E/071204

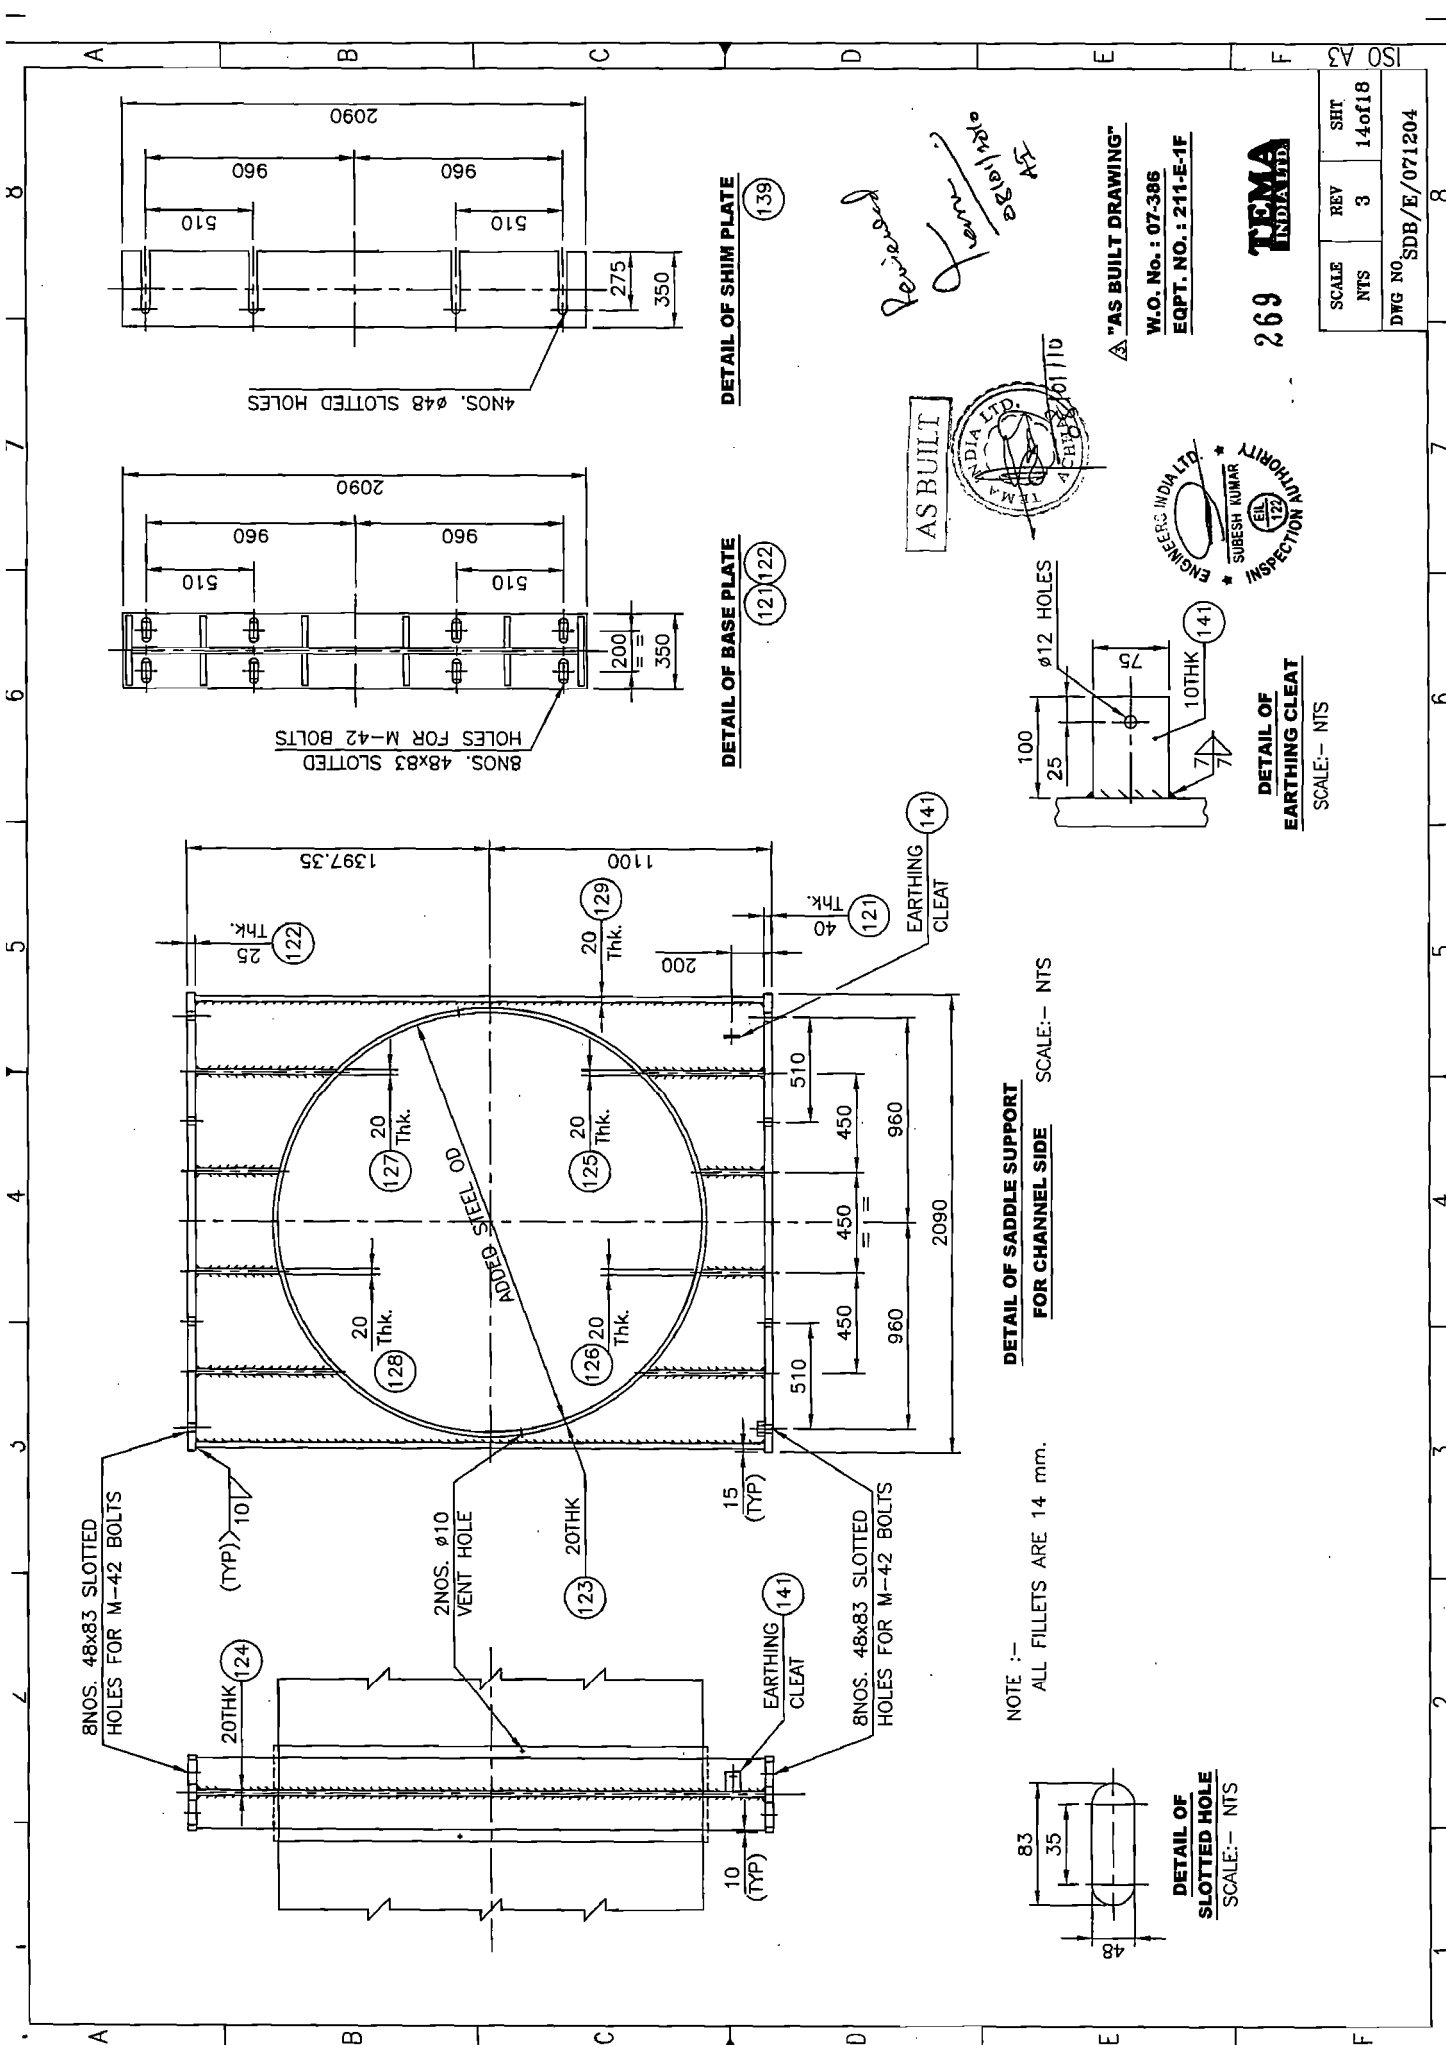

8NOS. 48x83 SLOTTED HOLES FOR M-42 BOLTS

20THK (TYP)


2NOS. Ø10 VENT HOLE

20THK

15 (TYP)


8NOS. 48x83 SLOTTED HOLES FOR M-42 BOLTS

NOTE :- ALL FILLETS ARE 14 mm.

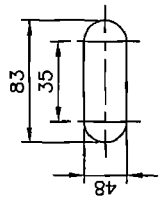


**DETAIL OF SLOTTED HOLE**  
SCALE:- NTS


**DETAIL OF SADDLE SUPPORT FOR CHANNEL SIDE**  
SCALE:- NTS

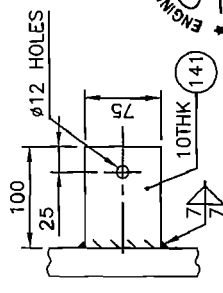

**DETAIL OF EARTHING CLEAT**  
SCALE:- NTS

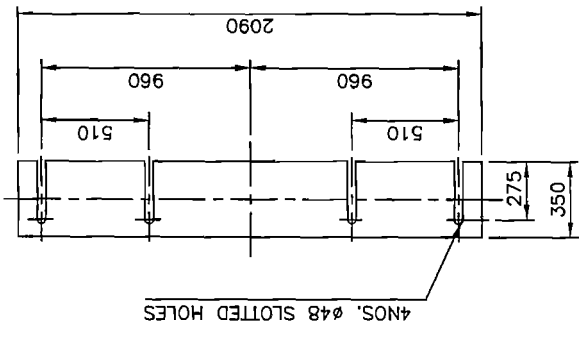

**DETAIL OF SHIM PLATE**  
SCALE:- NTS

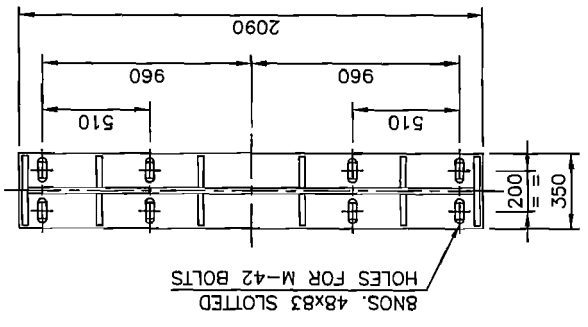

**DETAIL OF BASE PLATE**  
SCALE:- NTS

*Revised Drawing*  
25/11/2015

AS BUILT













"AS BUILT DRAWING"  
W.O. No. : 07-386  
EQPT. NO. : 211-E-1F




269 TEMA INDIA LTD.

SCALE	REV	SHT
NTS	3	14 of 18
DWG NO.	SDB/E/071204	



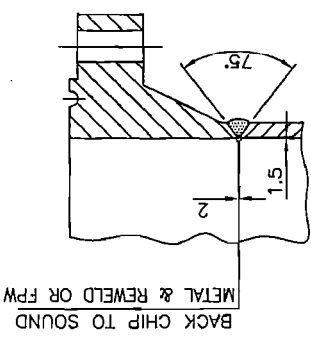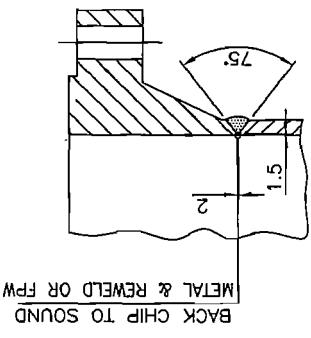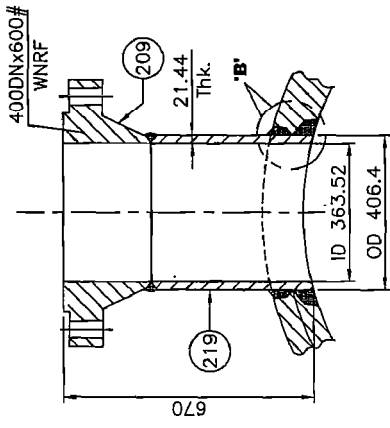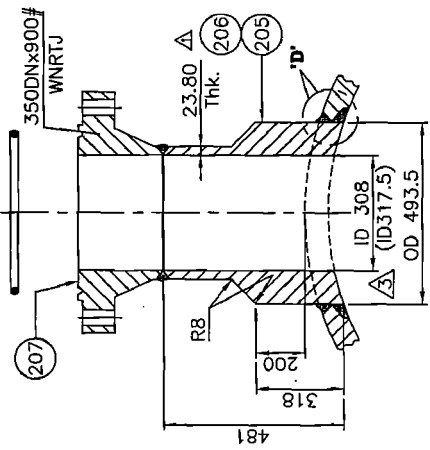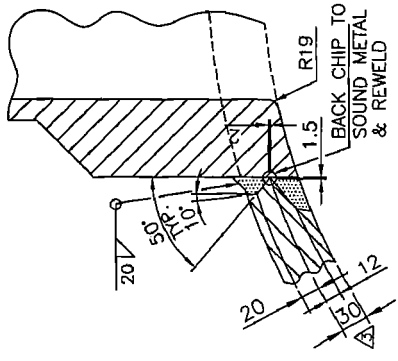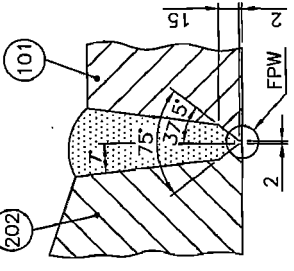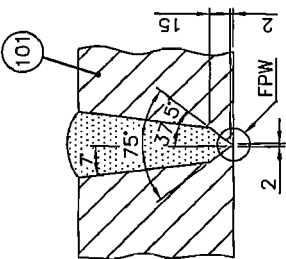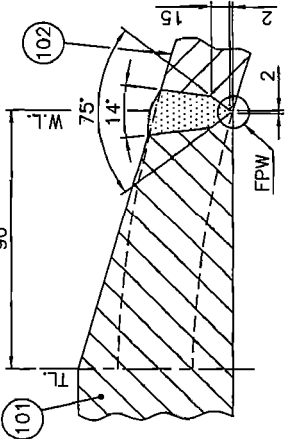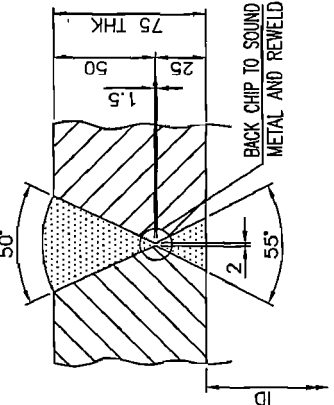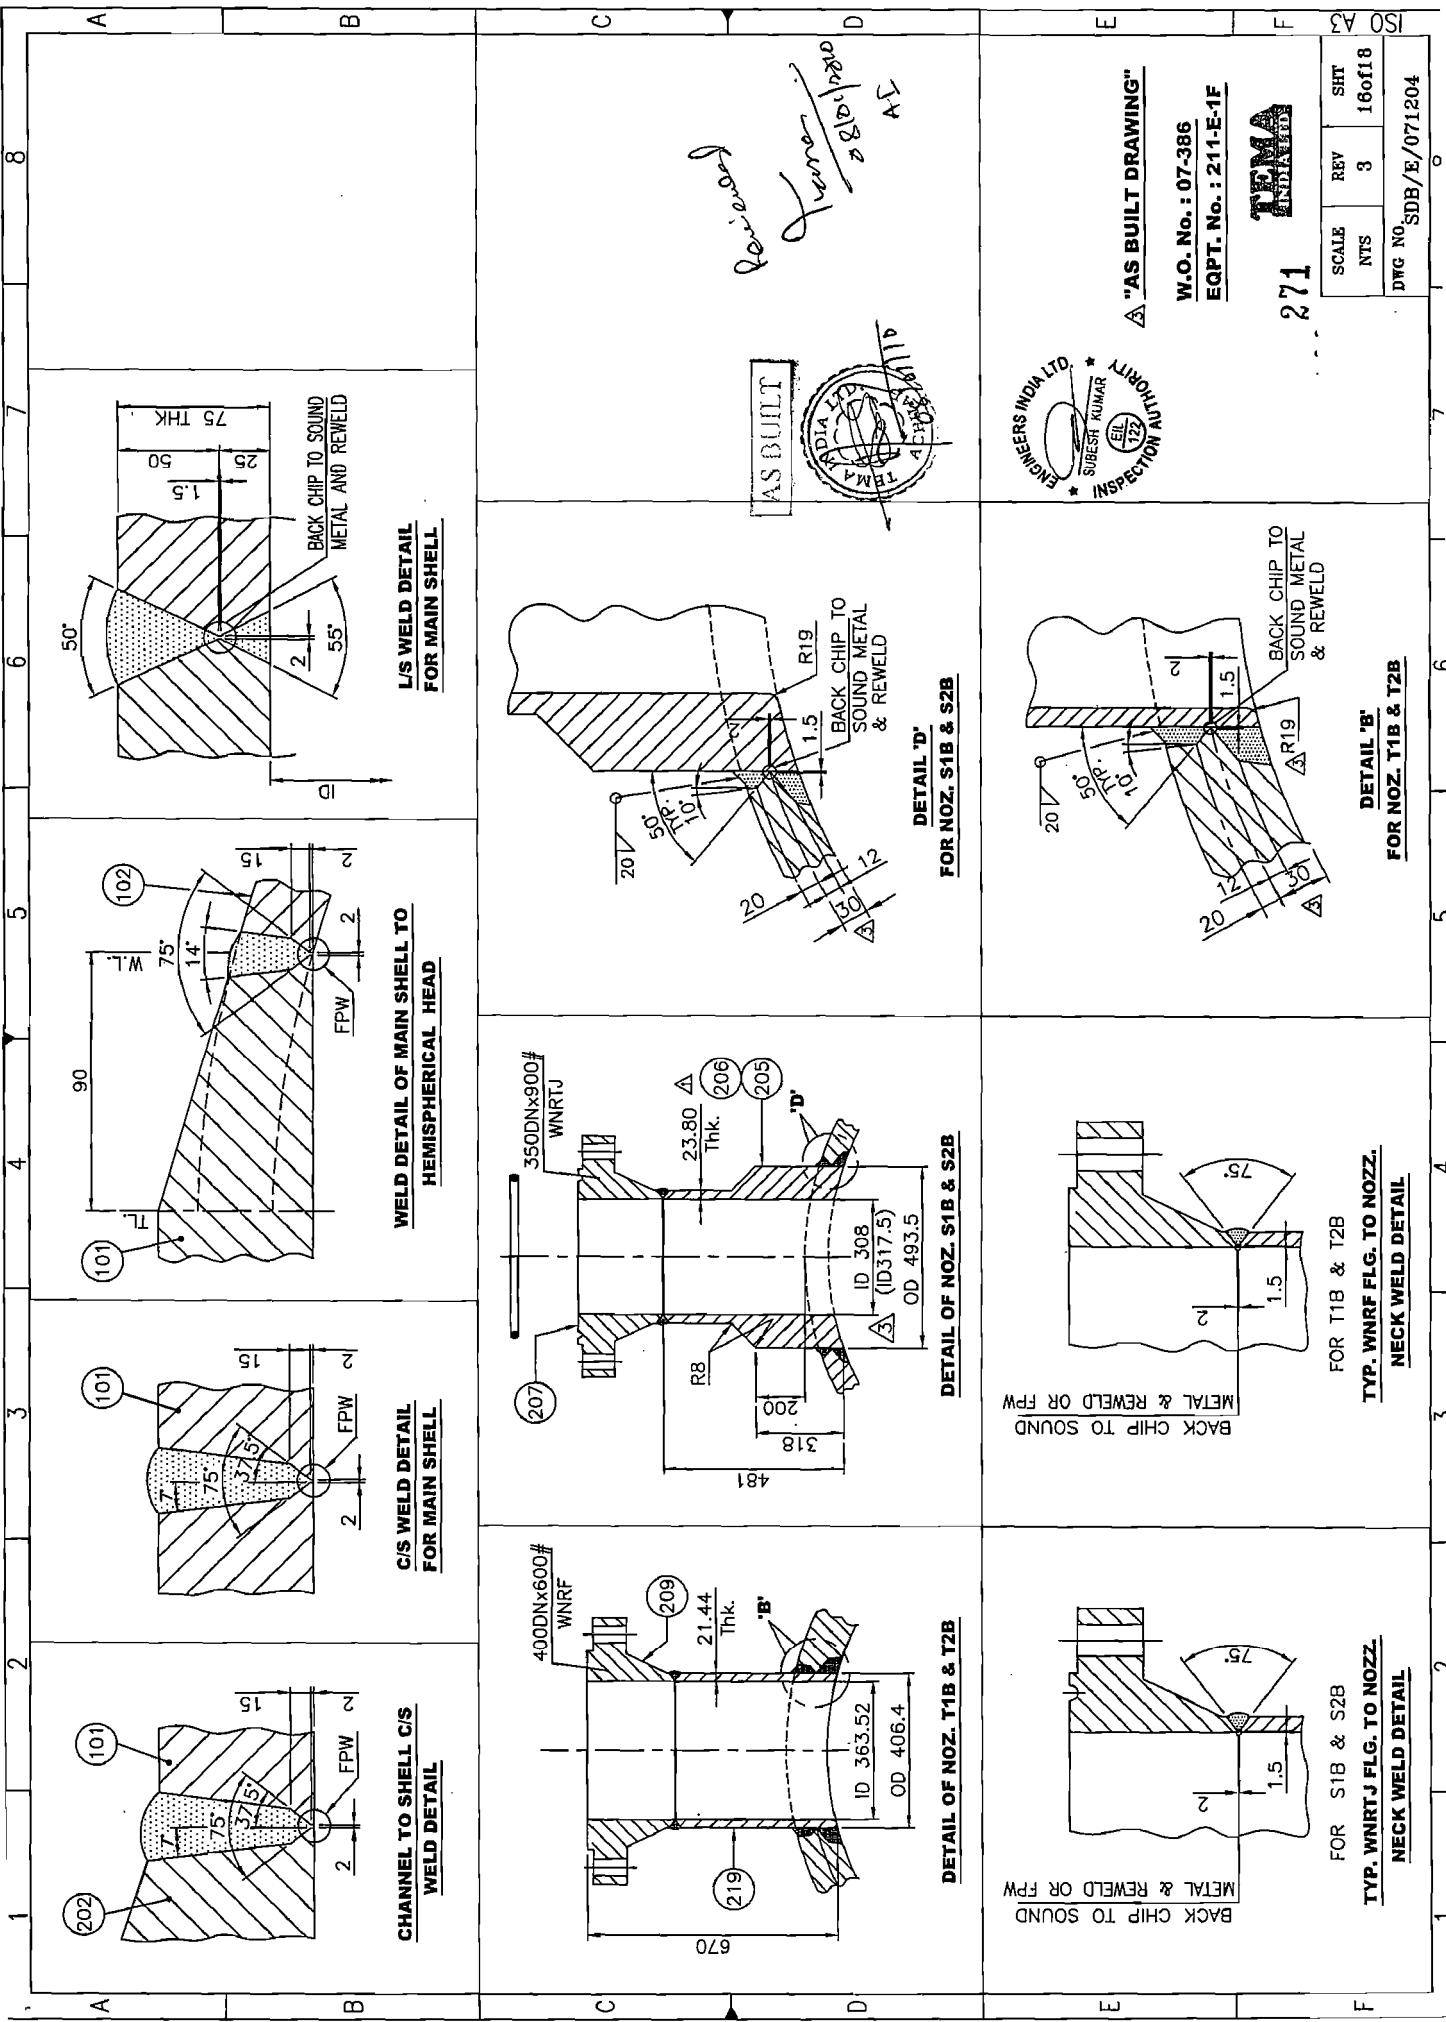

*Handwritten:* Approved June 28/01/2010 AI

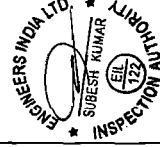

**"AS BUILT DRAWING"**  
 W.O. No. : 07-386  
 EQPT. No. : 211-E-1F





271

SCALE	REV	SHT
NTS	3	16of18
DWG NO. SDB/E/071204		






~8250 REQD. TO REMOVE BUNDLE  
 ~8354 FOR 'E' & ~8307.5 FOR 'F' OVERALL LENGTH  
 6031

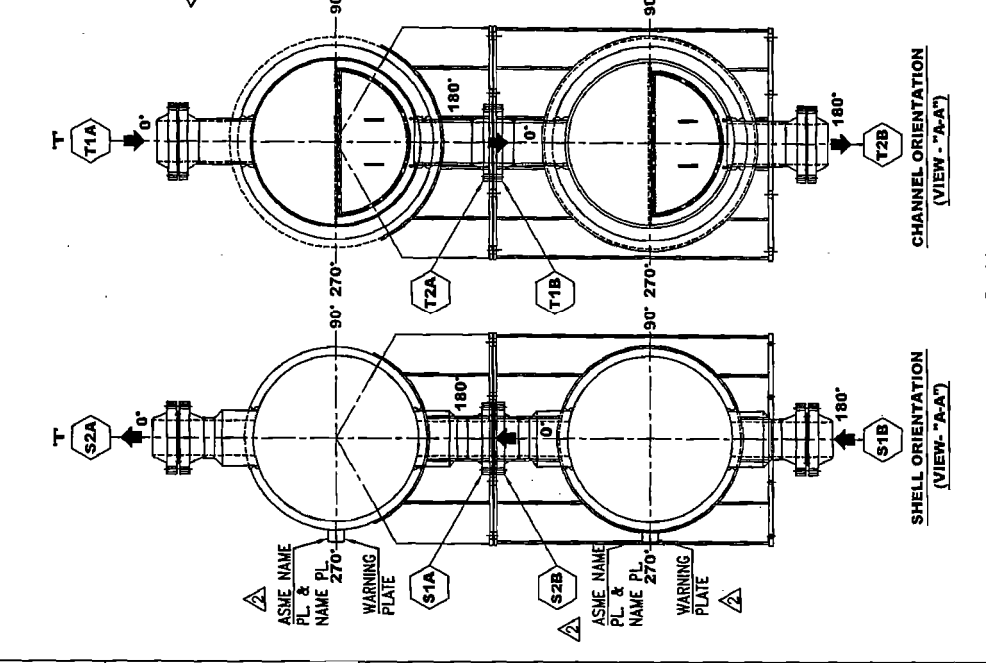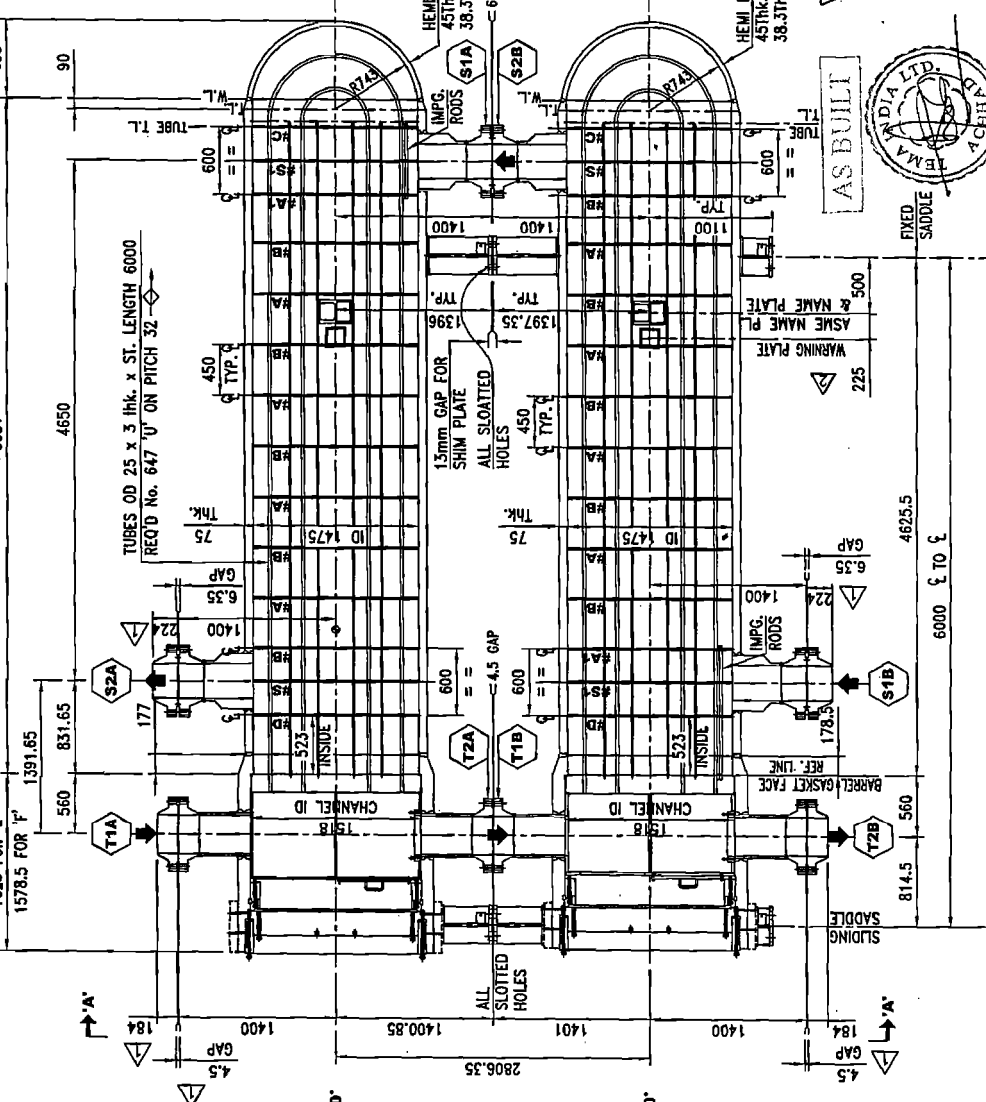

W.O. No. : 07-386  
 ECPT. NO. : 211-E-1E/F  
**273 TEMA INDIA LTD.**  
 AS BUILT  
 AS SHOWN  
 REV 3  
 SHT 18 of 18  
 DWG NO. SDB/E/071204

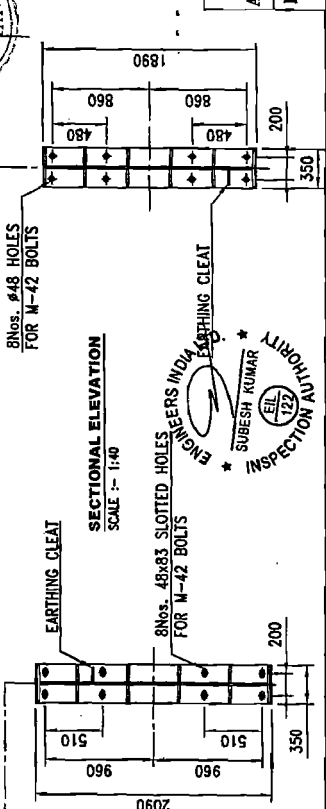

FOUNDATION LOADS

LOCATION	SADDLE LOAD (CHANNEL SIDE)			SADDLE LOAD (SHELL SIDE)		
	VERTICAL REACTION (kgf) (Z)	LONGITUDINAL SHEAR FORCE (kgf) (Y)	LONGITUDINAL TRANVERSE MOMENT (kgf-m) (X)	VERTICAL REACTION (kgf) (Z)	LONGITUDINAL SHEAR FORCE (kgf) (Y)	LONGITUDINAL TRANVERSE MOMENT (kgf-m) (X)
ERECTOR	-55106	-	-	-87744	-	-
FULL OF WATER	-67536	-	-	-147932	-	-
OPERATING	-122159	-33000	-33000	-18441	-33000	-36300
BUNDLE PULLING	-	-36000	-	-	-	-
SISAC LOAD (AT OPERATING CONDITION)	-	3269	34083	3550	33496	3605
WIND LOAD	-	3572	3423	22156	22156	3465

SECTIONAL ELEVATION  
 SCALE 1:140  
 ENGINEERS INDIA  
 SUBESH KUMAR  
 EIT  
 173  
 PROFESSIONAL INDEPENDENT